



FILED
 GREENVILLE CO., S.C.
 Nov 15 3 58 PM '85
 DONNIE S. TANKERSLEY
 R.M.C.

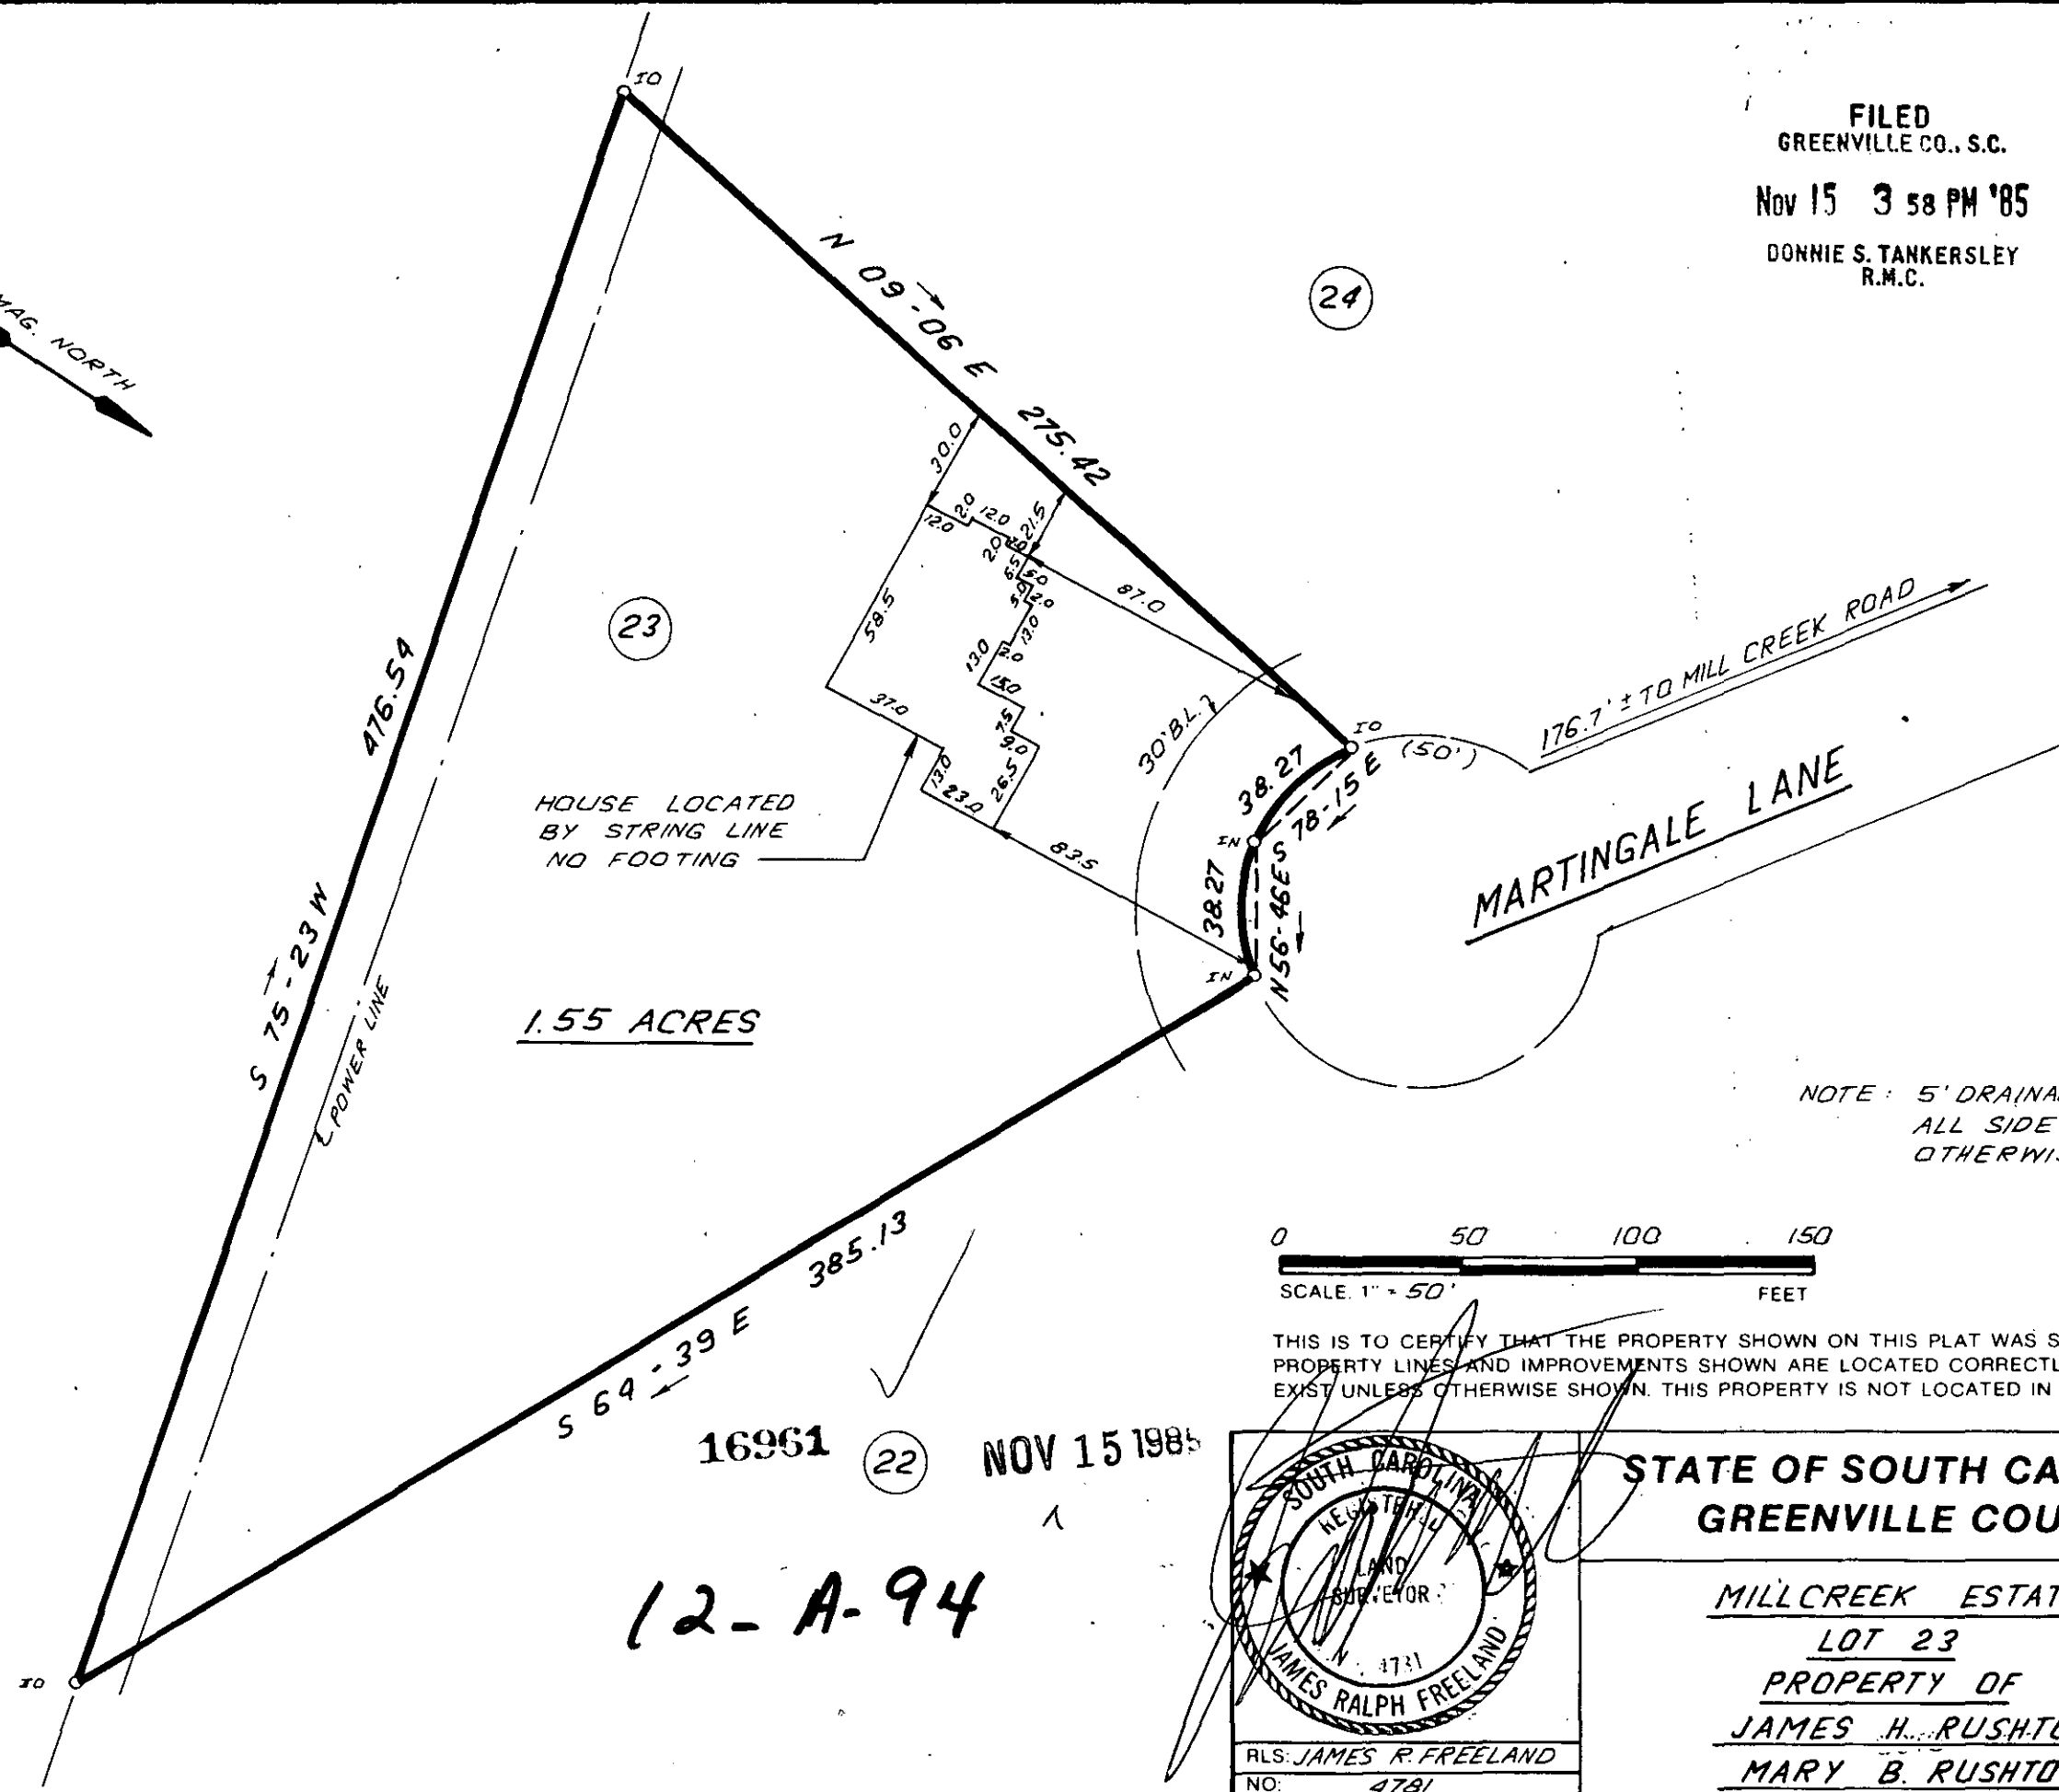

NOTE: 5' DRAINAGE & UTILITY EASEMENT ALONG ALL SIDE & REAR LOT LINES, UNLESS OTHERWISE NOTED.

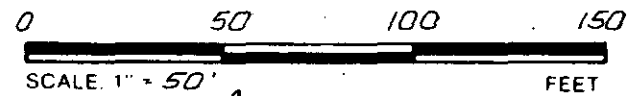

THIS IS TO CERTIFY THAT THE PROPERTY SHOWN ON THIS PLAT WAS SURVEYED UNDER MY DIRECT SUPERVISION. PROPERTY LINES AND IMPROVEMENTS SHOWN ARE LOCATED CORRECTLY AND THAT NO VISIBLE ENCROACHMENTS EXIST UNLESS OTHERWISE SHOWN. THIS PROPERTY IS NOT LOCATED IN A DESIGNATED FLOOD HAZARD AREA.

16961 (22) NOV 15 1985

12-A-94

SOUTH CAROLINA
 REGISTERED
 LAND SURVEYOR
 JAMES RALPH FREELAND
 No. 4781

RLS: JAMES R. FREELAND
 NO: 4781

STATE OF SOUTH CAROLINA
 GREENVILLE COUNTY

MILLCREEK ESTATE
 LOT 23
 PROPERTY OF
 JAMES H. RUSHTON, 1585
 MARY B. RUSHTON

FREELAND & ASSOCIATES
 Engineers • Land Surveyors
 318 WEST STONE AVENUE.
 GREENVILLE, S.C.
 (803) 271-4924

PLAT BOOK	4X-88
DEED BOOK	1246-399
TAX MAP	594.3-1-23
PARTY CHIEF	R. J. ...
DRAWN	I.R.
DATE	NOV-14-85
DWG. NO.	14135