

MICROFILMED

**NOTES**

THERE IS A 5' UTILITY AND DRAINAGE EASEMENT ALONG EACH SIDE OF ALL SIDE PROPERTY LINES, AND A 5' EASEMENT ALONG EACH SIDE OF REAR PROPERTY LINES.


**REVISIONS AND RECERTIFICATIONS**

| NO. | BY  | DATE      | DESCRIPTION        | JOB NO. REFERENCE | APP. |
|-----|-----|-----------|--------------------|-------------------|------|
| 1   | STH | 12 NOV 85 | ADDED WALKS, DRIVE | 85214             | WNS  |
| 2   |     |           |                    |                   |      |
| 3   |     |           |                    |                   |      |
| 4   |     |           |                    |                   |      |
| 5   |     |           |                    |                   |      |

**REFERENCES**

| BB          | DB         | PB     |
|-------------|------------|--------|
|             |            | 10M-2  |
|             |            | 9W-90  |
| 539.13-1-33 | 1211 / 713 | 9W-90  |
| 539.13-1-32 | "          | "      |
| 539.13-1-34 | "          | "      |
| 539.13-1-30 | "          | "      |
| 539.13-1-31 | 1252 / 559 | "      |
|             |            | 10M-92 |


**LOCATION MAP**

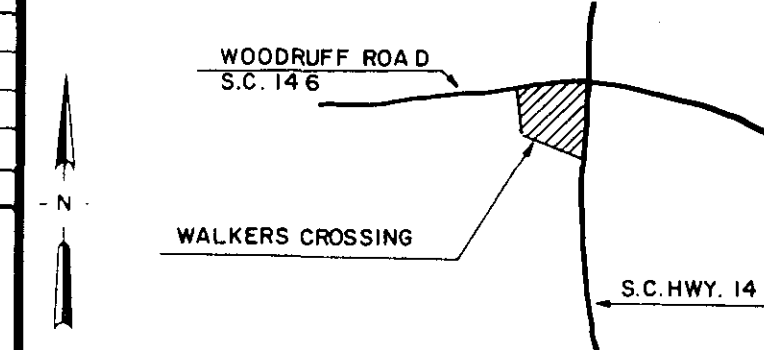

FILED  
GREENVILLE CO., S.C.  
NOV 18 11 24 AM '85  
DORRIS S. TANKERSLEY  
R.M.C.

WALKER WAY

100' ± TO THE INTERSECTION OF THE R/W OF WALKERS WAY AND MCCARY COURT.

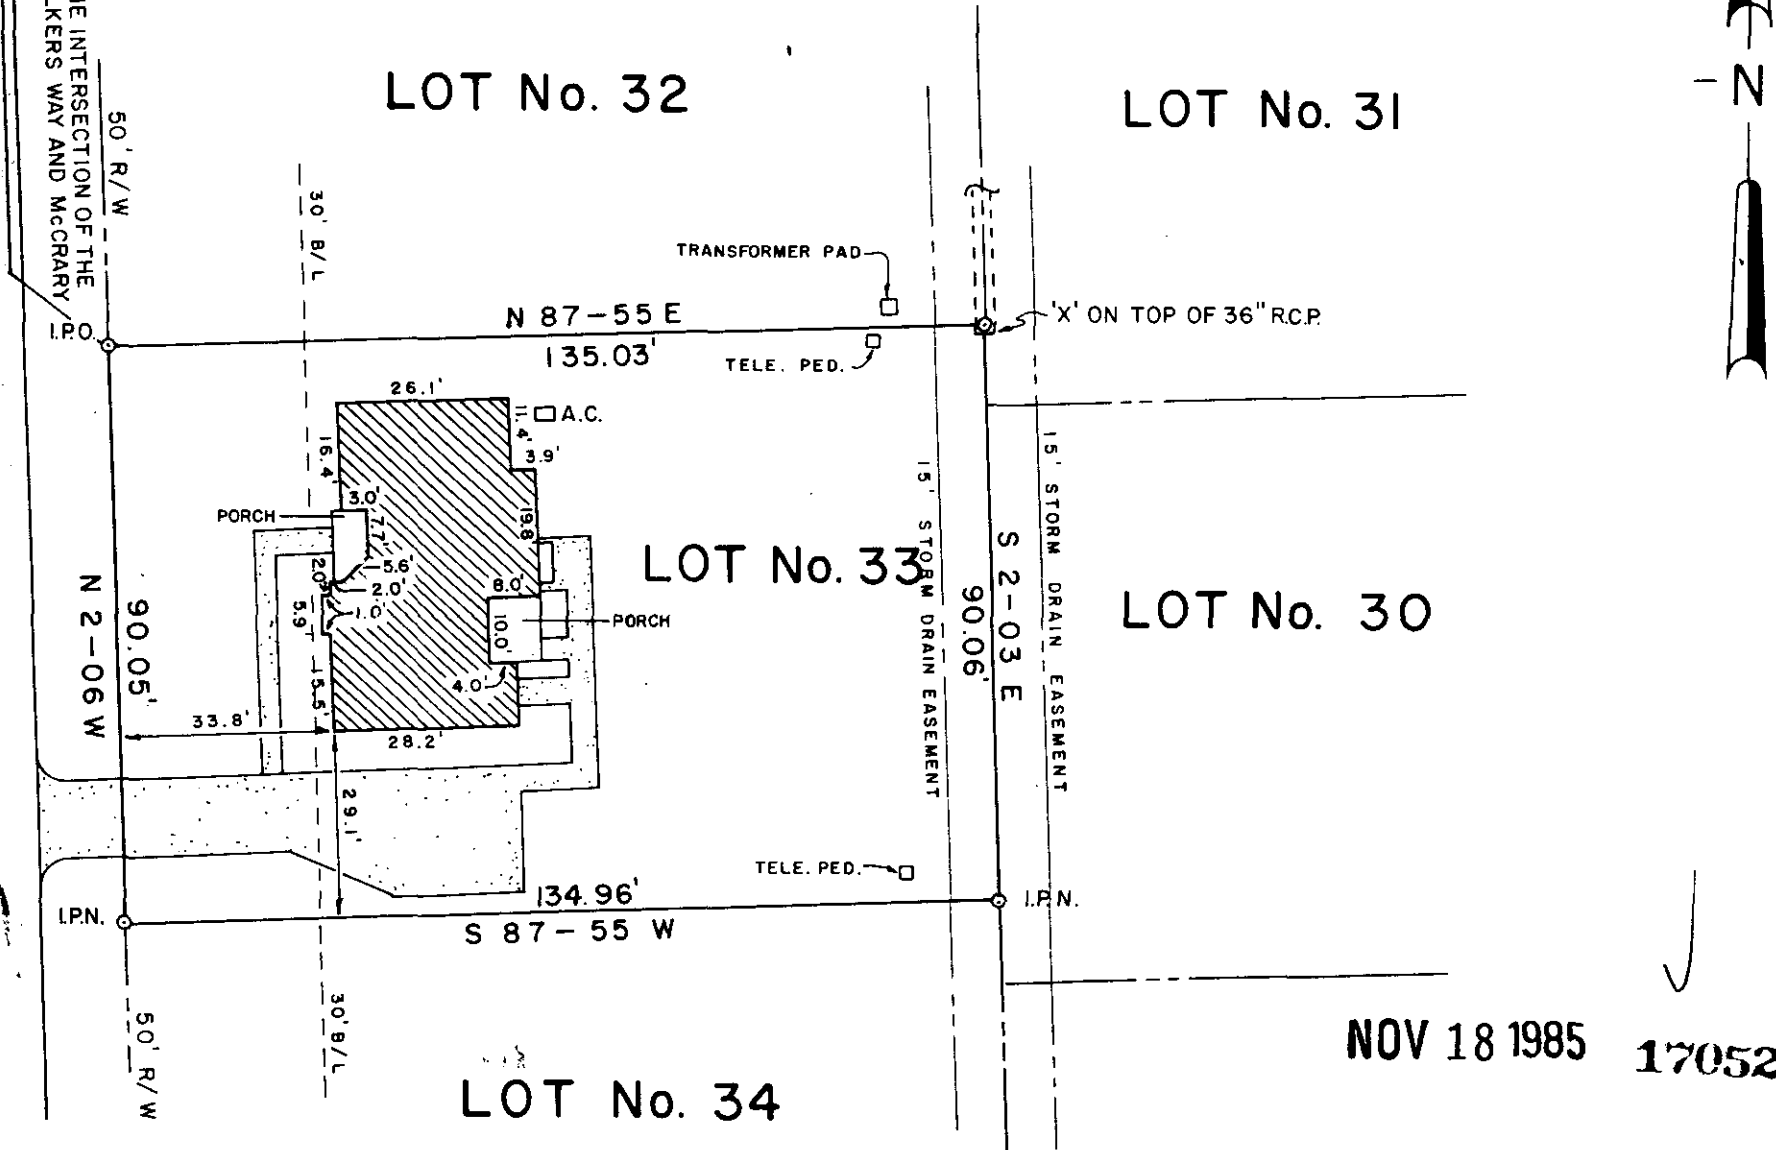

MAGNETIC

**CERTIFICATION**

THIS IS TO CERTIFY TO U.S. SHELTER CORP. THAT AN ACTUAL FIELD SURVEY WAS PERFORMED ON THIS PROPERTY UNDER MY SUPERVISION AND I DECLARE THAT:

(1) THE FIELD SURVEY AND THIS PLAT REPRESENT A DEPENDENT RESURVEY OF THE SUBJECT PROPERTY AND THAT THE INFORMATION SHOWN HEREON IS CORRECT TO THE BEST OF MY PROFESSIONAL KNOWLEDGE AND BELIEF

(2) ALL RIGHTS OF WAY, EASEMENTS AND ENCROACHMENTS, OBVIOUS AND APPARENT FROM FIELD OBSERVATION OF THE SUBJECT PROPERTY AT THE TIME OF THE SURVEY ARE AS SHOWN.

(3) THE AREA OF THE SUBJECT PROPERTY WAS CALCULATED BY COORDINATES AND THAT THIS IS A CLASS 'B' SURVEY.

*William V. Shaw*  
SIGNATURE OF REGISTERED LAND SURVEYOR DATE 11/18/85 S.C. REG. NO. 7261

THIS IS TO CERTIFY TO THAT THIS DRAWING IS A COMPOSITE PLAT AND DOES NOT CONSTITUTE AN ACTUAL FIELD SURVEY, AND THAT ANY USE OF THIS DRAWING FOR ANY PURPOSE OTHER THAN GENERAL REFERENCE IS DONE SO WITH THE UNDERSTANDING THAT ARBOR ENGINEERING INC. ASSUMES NO RESPONSIBILITY OR LIABILITY FOR ITS ACCURACY OR CORRECTNESS.

SIGNATURE OF REGISTERED LAND SURVEYOR DATE S.C. REG. NO.

THE DEPARTMENT OF HOUSING AND URBAN DEVELOPMENT FLOOD WAY DATA FOR GREENVILLE COUNTY SHOWS THIS PROPERTY  TO BE IN A FLOOD PLAIN AREA  NOT TO BE IN A FLOOD PLAIN AREA  LOCATION CANNOT BE DETERMINED.

THIS PLAT DOES NOT CONSTITUTE OR WARRANT COMPLIANCE OR NON-COMPLIANCE WITH ANY ZONING OR BUILDING REGULATION, MUNICIPAL ORDINANCE OR SUBDIVISION REGULATION UNLESS SPECIFICALLY STATED ELSEWHERE ON THIS DRAWING.

**PROPERTY SURVEY FOR STEVEN A. & CONNIE E. PYNNE**

**LOT No. 33  
WALKERS CROSSING  
GREENVILLE SOUTH CAROLINA**

SCALE 30 0 30 60

|             |                         |               |                  |
|-------------|-------------------------|---------------|------------------|
| RESEARCH TR | DRAWN WNS               | CHECK TAG     | DATE 19 AUG 1985 |
| FILE        | FIELD WORK BY T.R.-M.J. | JOB NO. 85214 |                  |

**ARBOR ENGINEERING**  
P.O. BOX 263, GREENVILLE, S.C.  
LANDSCAPE ARCHITECTS-ENGINEERS-LAND SURVEYORS

NOV 18 1985 17052

12-A-97

THE PRINT MACHINE, INC. N44795