

FILED  
GREENVILLE S.C.  
APR 4 10 07 AM '86  
DUNN & HENSLEY  
R.M.C.

—○— STORM DRAINAGE & H/W  
—○— SANITARY SEWER & MH  
—→— DRAINAGE DIRECTION

REVISED ENTRANCE & MEDIAN  
PER SCDHEPT DIRECTION  
(NOTE REV. #1 CRS. IRRIG. DWG. CR)



NOTES:


PROPERTY IN FLOOD ZONE C

PROPERTY SURVEY BY K.T. GRILL E.P.I.C.  
TOPG BY HEENER ENGR CO. INC.

Plat Filed This 4 day of Apr 1986  
And Recorded in Vol. 12-B Page 01 at 10:07 A.M.  
Register Mesne Conveyance Greenville County, S.C.

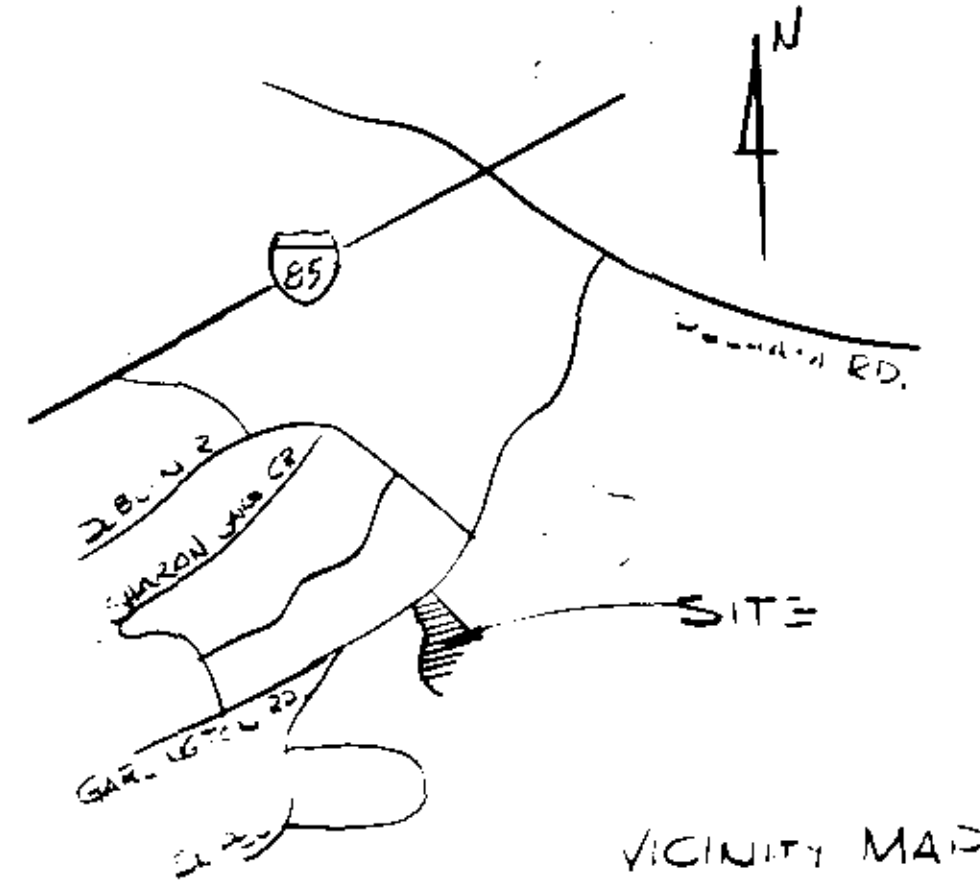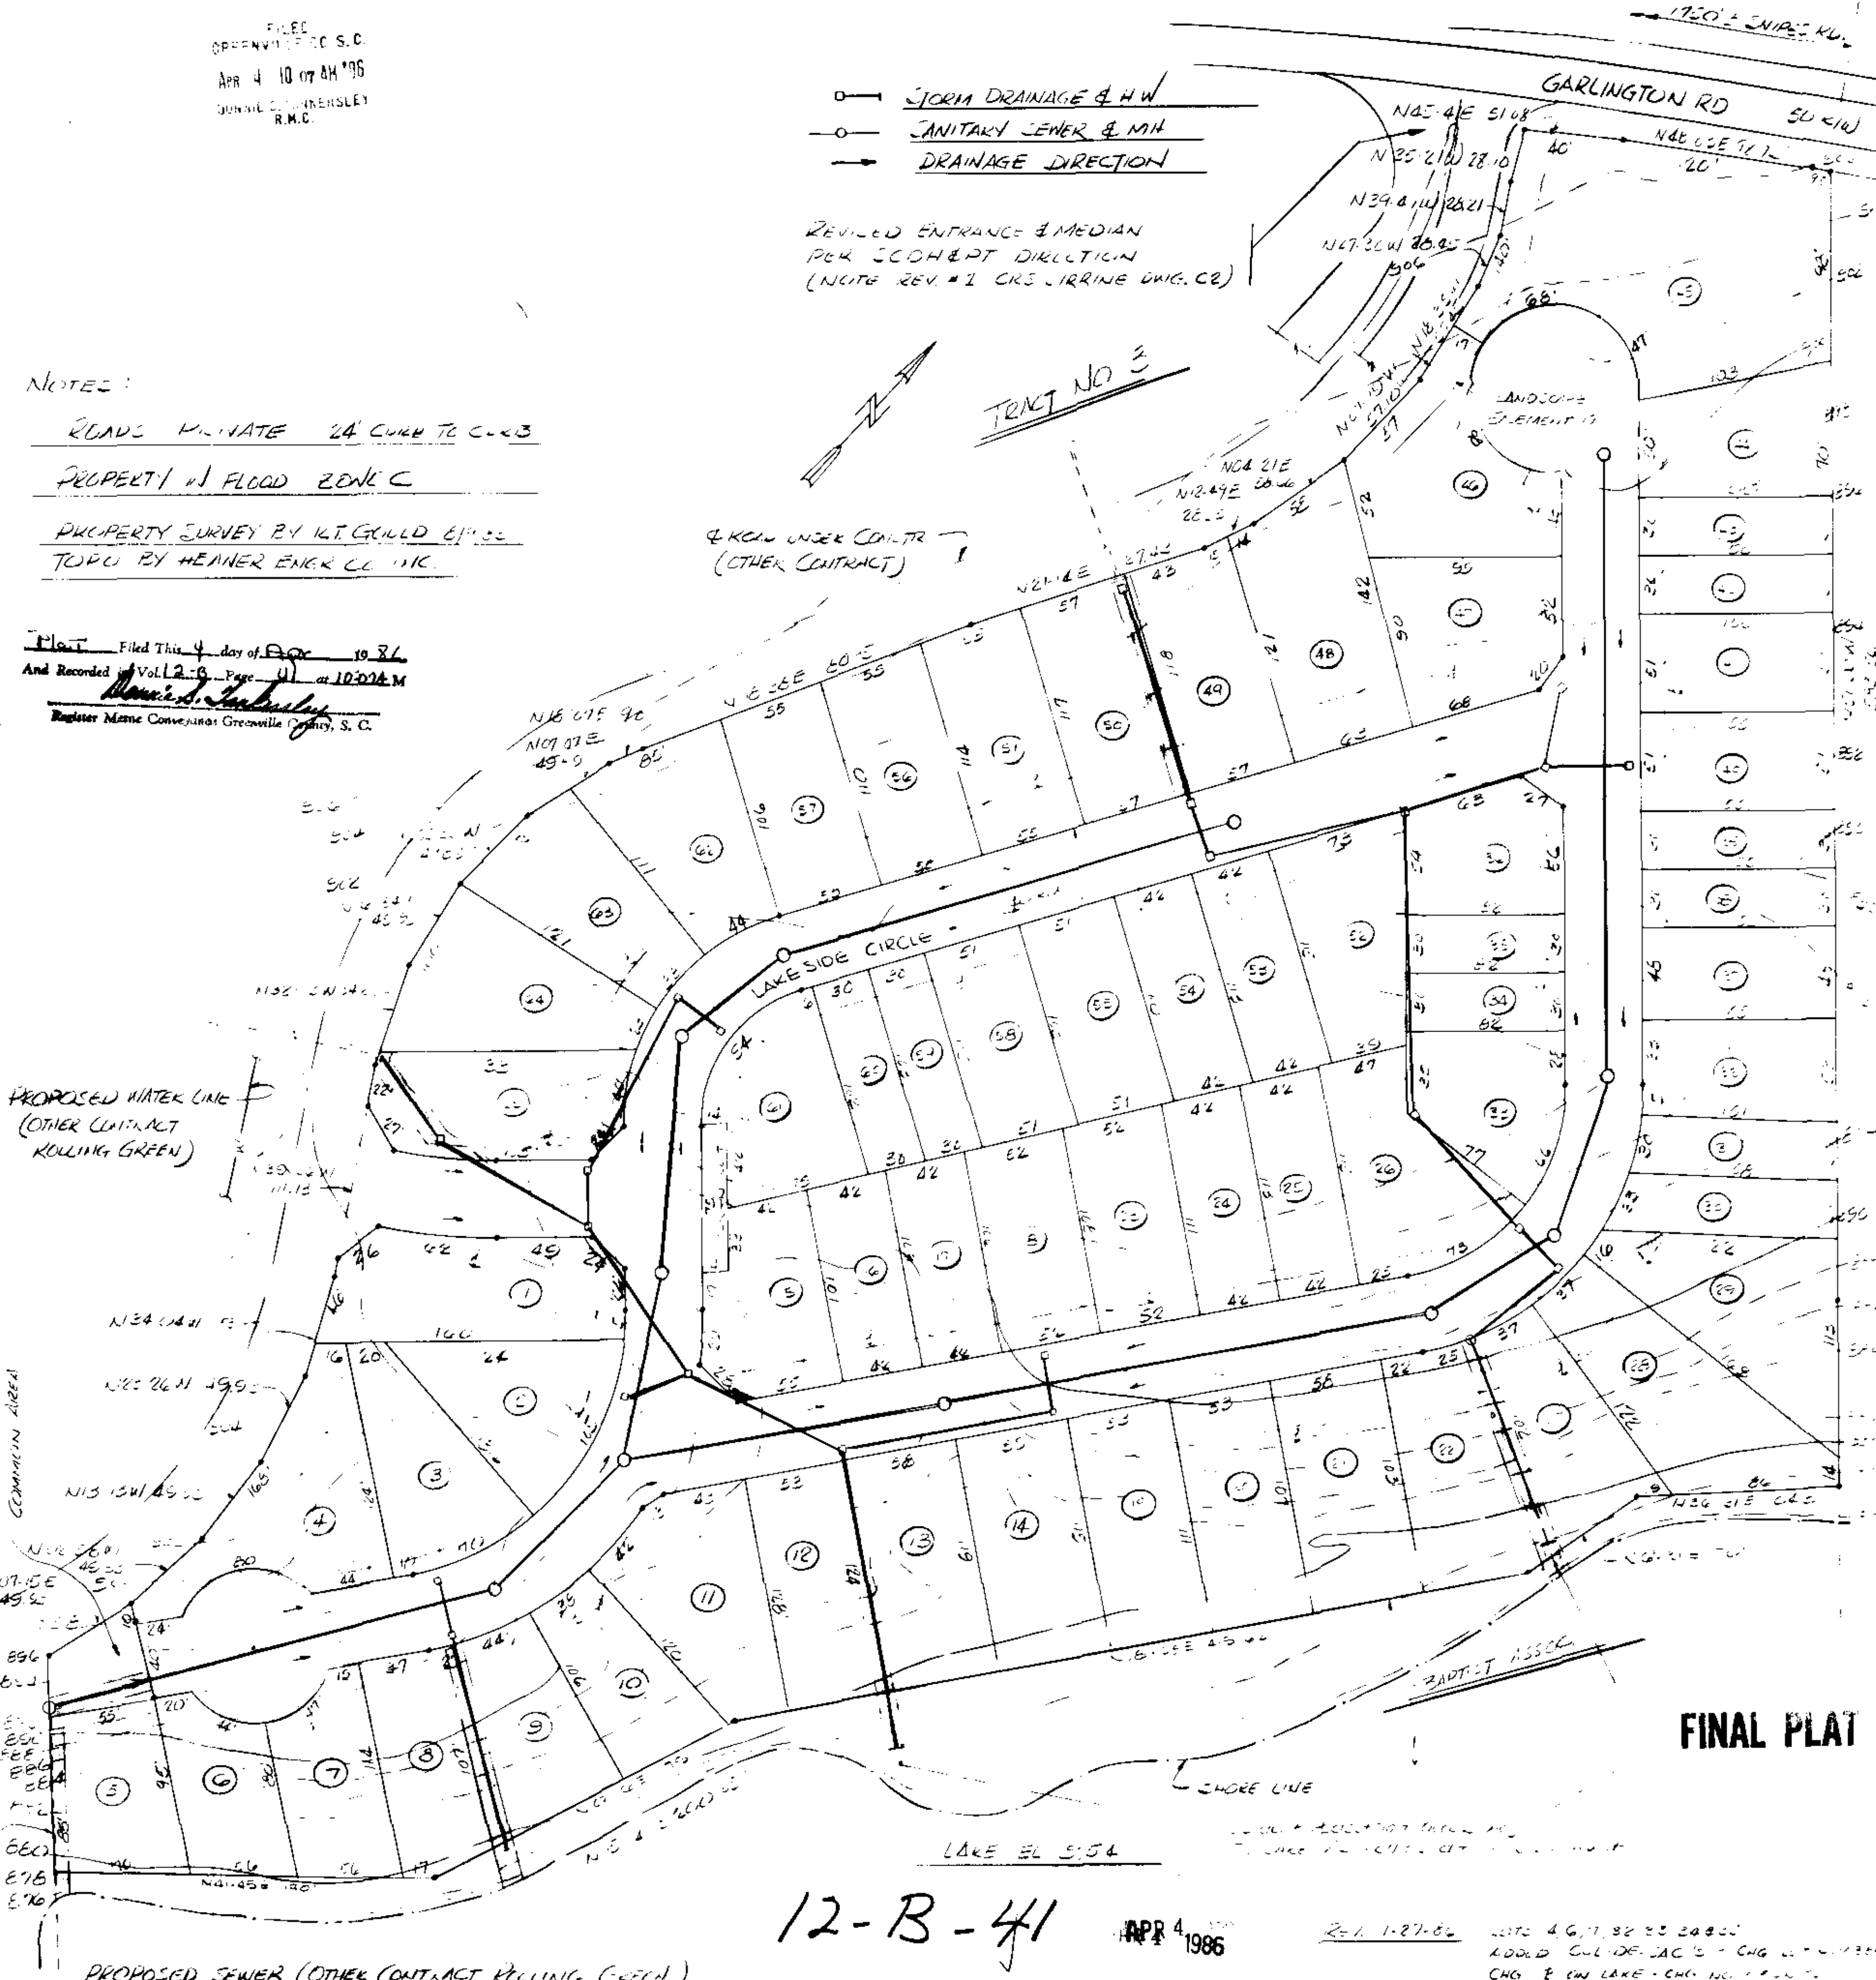

FINAL PLAT

CERTIFICATE OF OWNERSHIP AND DEDICATION

"The undersigned hereby acknowledge that I am (we are) the owner(s) of the property shown and described hereon and that I (we) hereby adopt this plan of subdivision with my (our) free consent and that I (we) establish the minimum building restriction lines, and hereby dedicate to public use as roads, streets, and easements, forever all areas so shown or indicated on said plat.

4.2.86 Signed *A.G. Hensley*  
\_\_\_\_\_  
Signed \_\_\_\_\_  
\_\_\_\_\_  
Signed \_\_\_\_\_  
\_\_\_\_\_  
Signed \_\_\_\_\_

CERTIFICATE OF ACCURACY

"I, WILLIAM C. INABINET certify that this plat was (drawn by me) (drawn under my supervision) (an actual survey made under my supervision) from (an actual survey made by me) (deed description recorded in Book \_\_\_\_\_ Page \_\_\_\_\_, etc.) (other); that the error of closure as calculated by latitudes and departures is 111.000; that the boundaries not surveyed are shown as broken lines plotted from information found in Book \_\_\_\_\_ Page \_\_\_\_\_; that this plat was prepared in accordance with the Greenville County Subdivision Regulations as adopted.

3-31-86 DATE  
W.C. Inabinet LICENSED ENGINEER (REGISTERED SURVEYOR)  
S.C. Registration No. 3511

CERTIFICATE OF APPROVAL FOR RECORDING

"I hereby certify that the subdivision plat shown hereon has been found to comply with the Subdivision Regulations for Greenville County, with the exception of such variances, if any, as are noted in the minutes of the Greenville County Planning Commission of Greenville County, South Carolina, and that it has been approved for recording in the office of the County Register of Mesne Conveyance."

4/3/1986 *John H. Williams*  
DIRECTOR OF PLANNING  
GREENVILLE COUNTY PLANNING COMMISSION

Each property owner is provided access to a public road by a private road of which each property owner has an undivided interest. The private access road will not be accepted and maintained as a public right of way until such time as it meets minimum county standards.

FILE NUMBER  
**85-177**

ROLLING GREEN TRACT 2


WESTMINSTER CO. GREENVILLE S.C. OWNER  
HEENER ENGR CO. INC. GREENWOOD S.C. ENGINEER OR SURVEYOR

NO. OF ACRES: 10.77 MILES OF NEW ROADS: 0.4

NO. OF LOTS: 65 DATE: 3-31-86

ZONE: PDR

SCALE: 1" = 50'

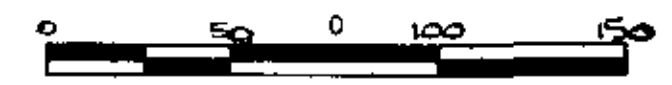

FINAL PLAT

12-B-41

APR 4 1986

REV. 1-27-86  
REV. 3-25-86  


32576

Complies w approved concept plan file