

LOCATION MAP

FINAL PLAT

CERTIFICATE OF OWNERSHIP AND DEDICATION

"The undersigned hereby acknowledge that I am (we are) the owner(s) of the property shown and described hereon and that I (we) hereby adopt this plan of subdivision with my (our) free consent and that I (we) establish the minimum building restriction lines, and hereby dedicate to public use as roads, streets, and easements, forever all areas so shown or indicated on said plat.

REV.
 MAY 20 1986
 Signed: *James M. Garrison, Jr.*
 Signed: *James M. Garrison, Jr.*
 Signed: _____
 Signed: _____

CERTIFICATE OF ACCURACY

"I, James P. Cain certify that this plat was (drawn by me) (drawn under my supervision) (an actual survey made under my supervision) from (an actual survey made by me) (deed description recorded in Book 1230 Page 51 Book _____ Page _____, etc.) (other); that the error of closure as calculated by latitudes and departures is _____ that the boundaries not surveyed are shown as broken lines plotted from information found in Book _____ Page _____ that this plat was prepared in accordance with the Greenville County Subdivision Regulations as adopted.
 REV. 7-16-86 J. D. Cain
 MAY 20 1986
 DATE
James P. Cain
 LICENSED ENGINEER OR REGISTERED SURVEYOR
 S.C. Registration No. 3320

CERTIFICATE OF APPROVAL FOR RECORDING

"I hereby certify that the subdivision plat shown hereon has been found to comply with the Subdivision Regulations for Greenville County, with the exception of such variances, if any, as are noted in the minutes of the Greenville County Planning Commission of Greenville County, South Carolina, and that it has been approved for recording in the office of the County Register of Mesne Conveyance."
6/19/86
 DATE
Aug 4 1986
John H. Williams, Jr.
 DIRECTOR OF PLANNING
 GREENVILLE COUNTY PLANNING COMMISSION
Lois A. Home

FILE NUMBER


86-128

I-385 SELF STORAGE REVISION 1

JUNIUS H. GARRISON, JR. THE PIEDMONT GROUP
 OWNER ENGINEER OR SURVEYOR

NO. OF ACRES: 2.658 MILES OF NEW ROADS: 0
 NO. OF LOTS: 3 DATE: 5-20-86
 REVISED: 7-16-86
 ZONE: _____

SCALE: 1" = 30'

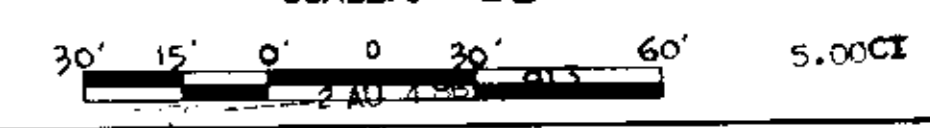

Plat Filed This 4 day of Aug 1986
 And Recorded in Vol. 12-8 Page 81 at 4:54pm

12-B-81 5451

REVISED
04-86
 DATE
 Shift Lot Line on
 Out Parcel of 442A

APPROVED *DA Fogli* DATE 6/3/86
 REVISED: 7-16-86 *DA Fogli* CITY ENGINEER

SEE
 RECORDS FOR S.C.
 JOB 1 4 54 PM
 1986
 R.M.C.

MAGNETIC NORTH

ROBERT M. GRAVES, ET AL
 Dp. 984-488
 N 7-48 E
 358.66'

N 7-48 E
 161.54'

OVERHEAD POWER
 87-48 W
 161.94'

N 89-15-30 E
 50.66'

N 89-15-30 E
 282.94'

CAMPERDOWN Co., INC.
 Dp. 1168-600

S 89-44 W
 50.6'

o I.O. IRON PIN OLD
 o I.N. IRON PIN NEW