MICROFILMED

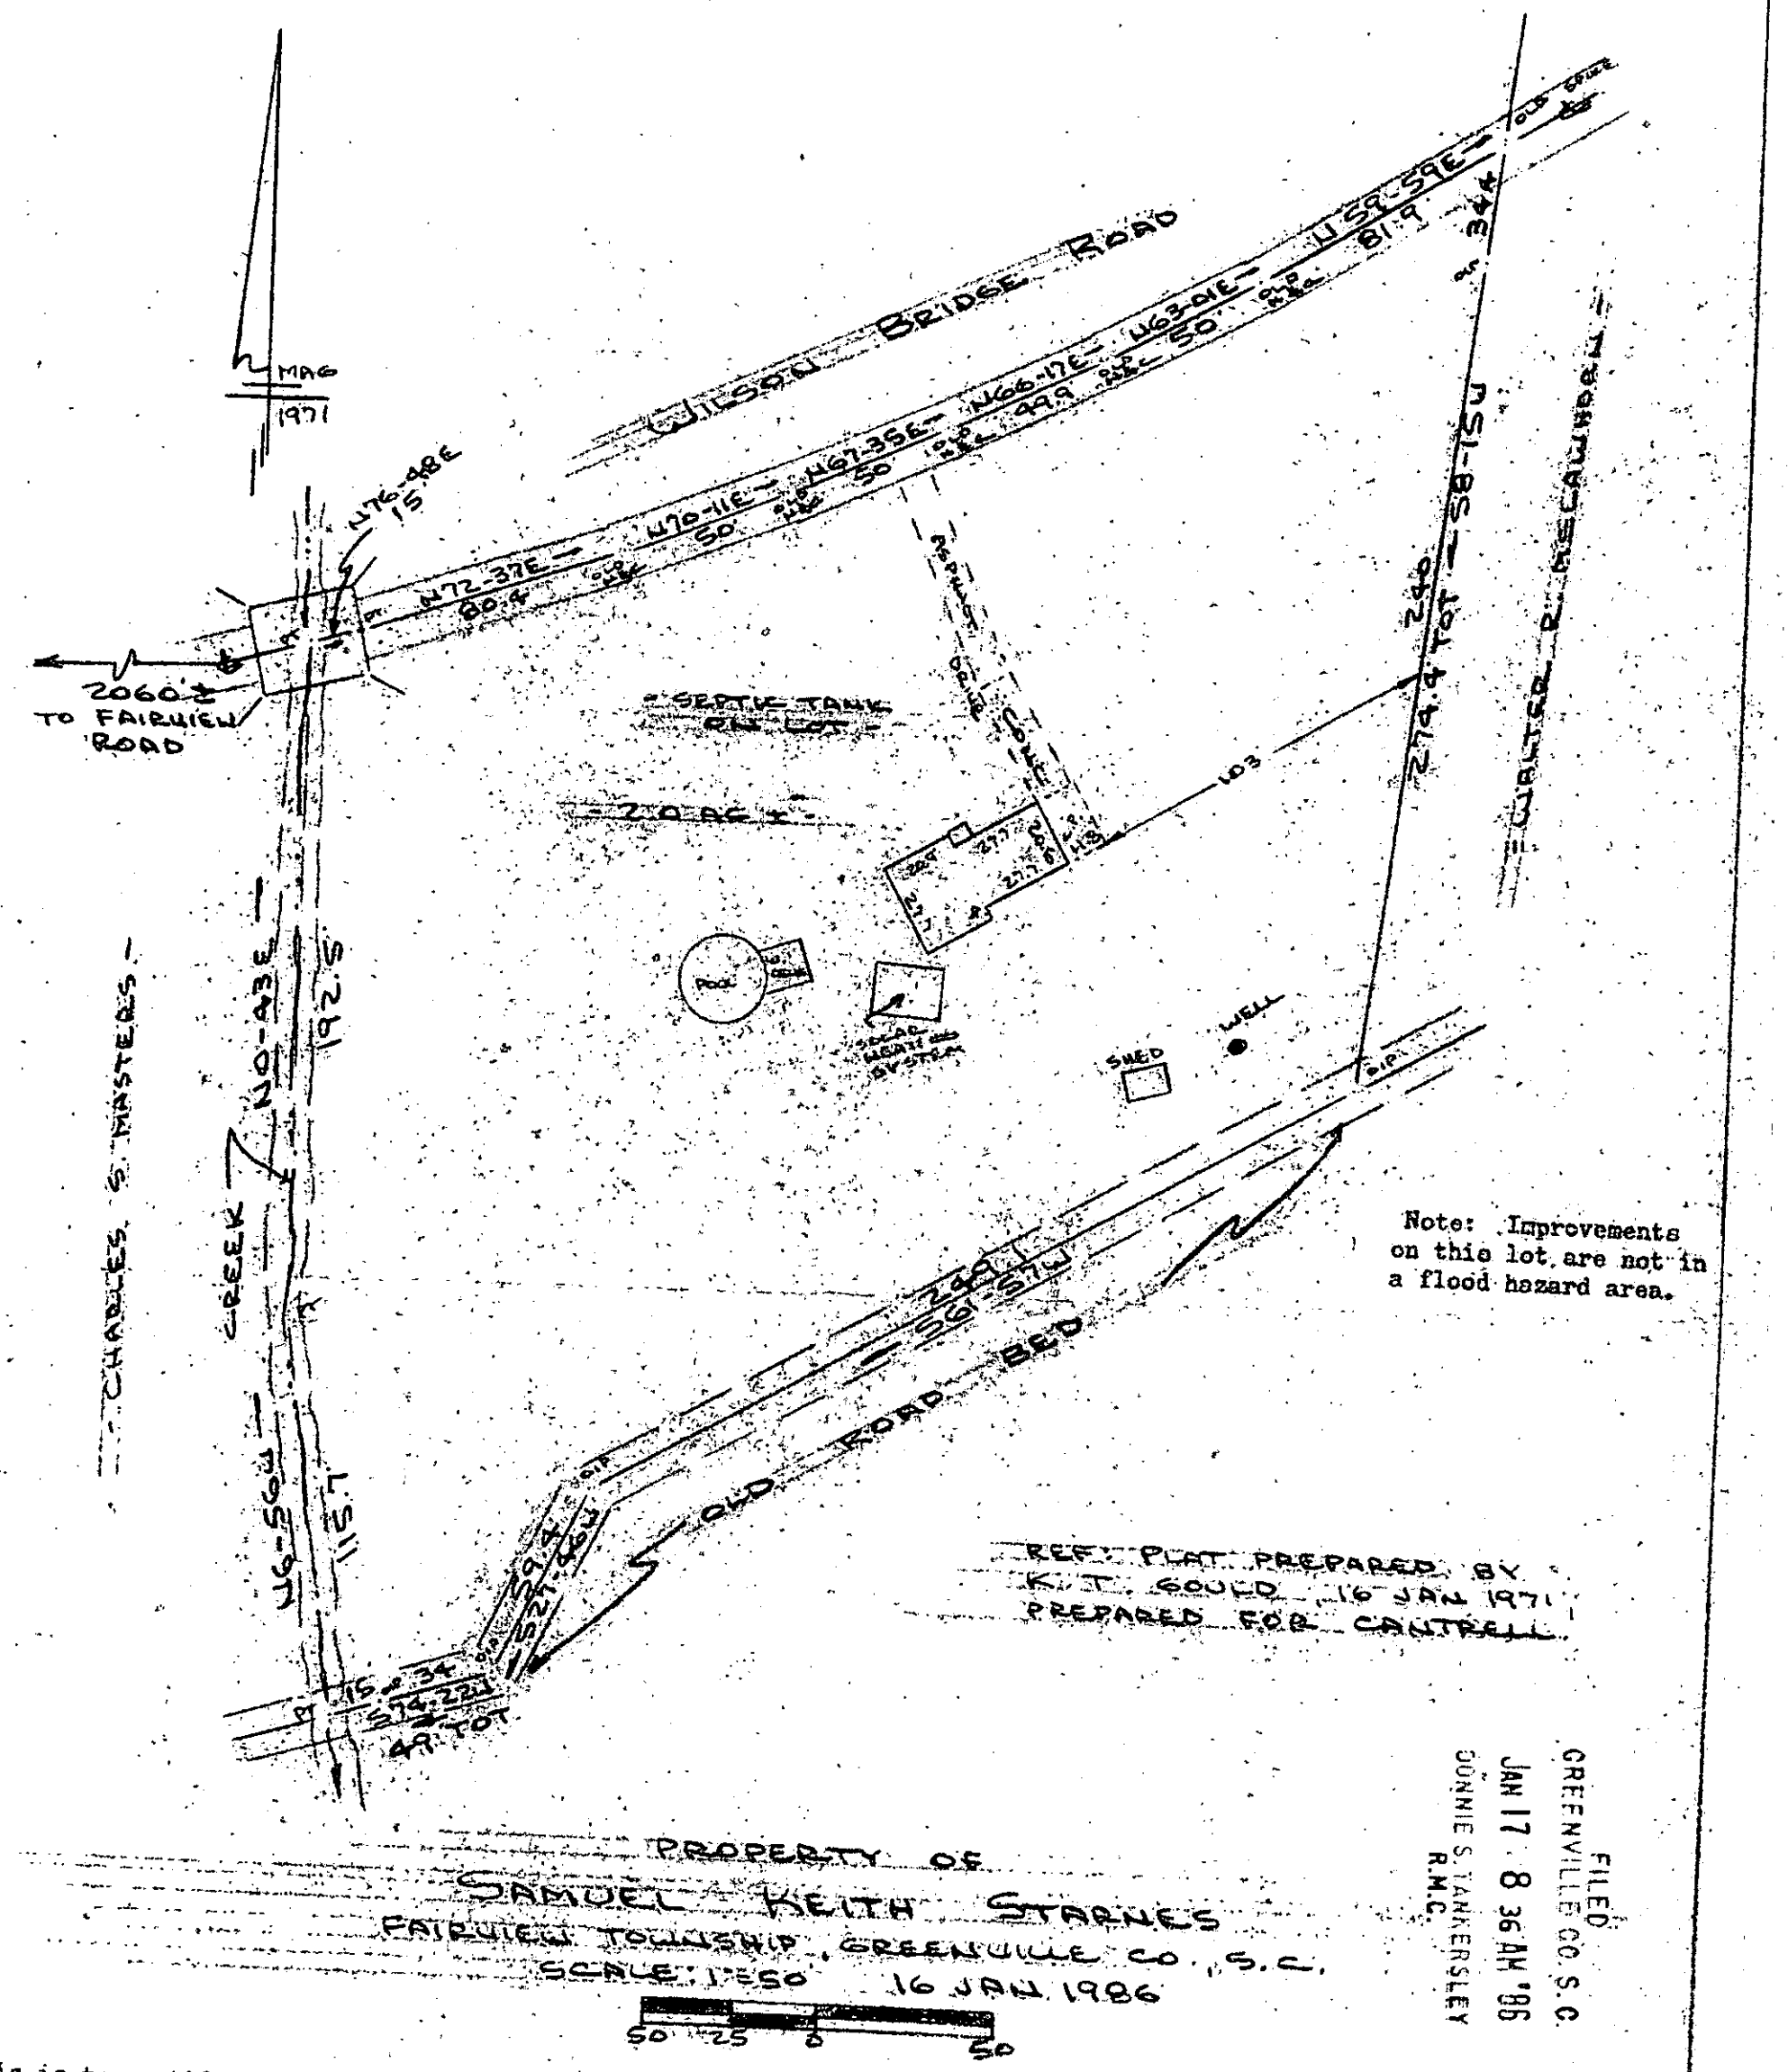

Note: Improvements on this lot are not in a flood hazard area.

FILED
GREENVILLE CO. S.C.
JAN 17 8 36 AM '86
DONNIE S. TANKERSLEY
R.M.C.

This is to certify that on the 16th day of January, 1986, I surveyed the property shown on this plat being known as PROPERTY OF ALVIN G. STEADING AND NANCY T. STEADING and recorded in deed book 1210 Page 192, and also being known as PROPERTY OF SAMUEL KEITH STARNES and recorded in Plat Book Page ; and that the property lines, walls and buildings are as shown hereon, and that the walls and buildings located on said lot do not encroach or project on adjacent street or property, and that no adjacent walls or buildings encroach or project on said premises, and no power lines cross this property except as shown hereon.

12-J-4

JAN 17 1986

23778

R. B. Bruce, RLS # 1952

CAROLINA SURVEYING CO.
112 Manly St.
Greenville, S. C.

Recordable Plat

R. B. BRUCE

360/29