

MICROFILMED


TYPICAL PLAN FOR THE FOLLOWING UNITS

33, 34, 35, 36

FILED
GREENVILLE CO. S. C.

JAN 23 4 12 PM '86

DONNIE S. TANKERSLEY
R.M.C.

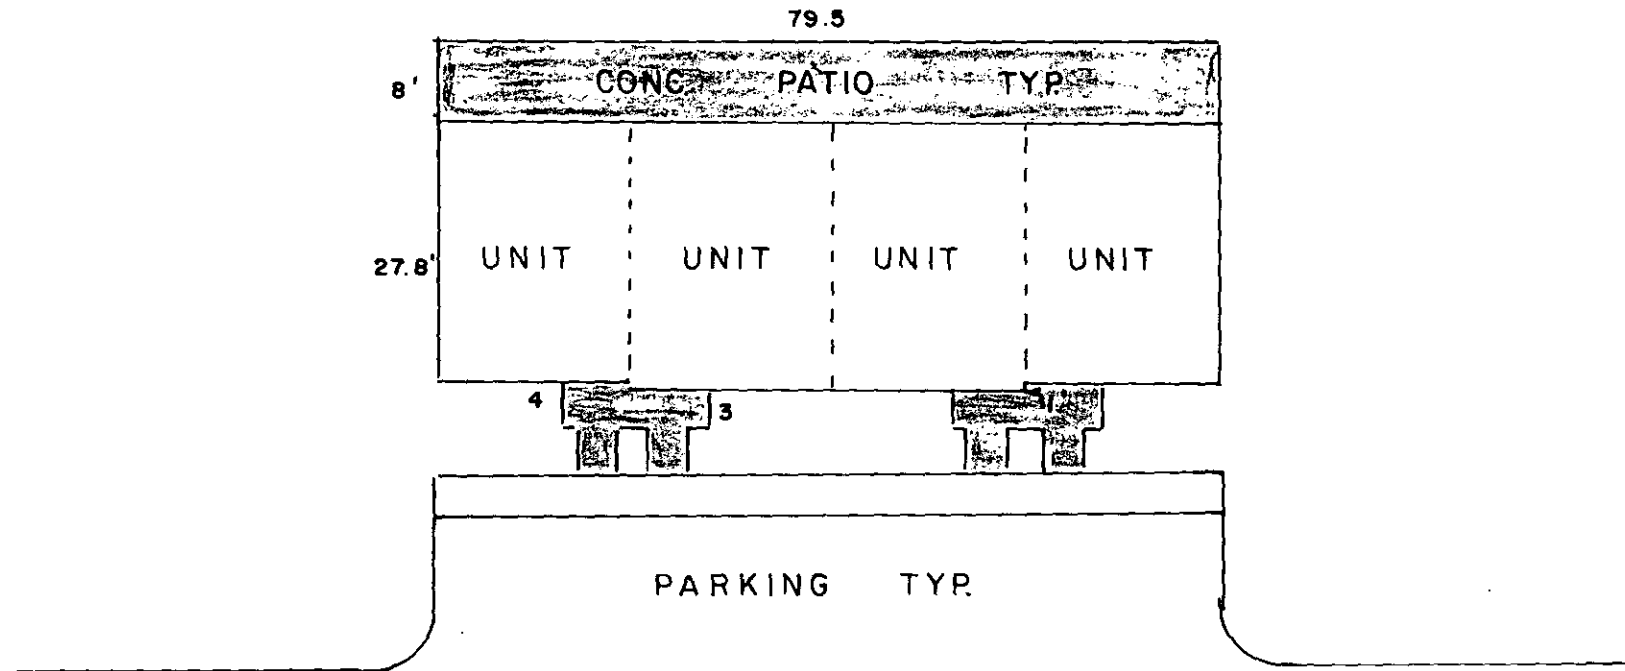

PAVED

ROAD

24383

JAN 23 1986

12-J-21

I HEREBY CERTIFY THE LIMITED COMMON ELEMENTS AS SURVEYED BY
WEBB SURVEYING GROUP AND AS SHOWN ON THIS DRAWING.

SIGNED Samuel D. King DATE 12-23-85

THIS PLAT IS NOT A SUBDIVISION
AS DEFINED BY THE GREENVILLE
COUNTY SUBDIVISION REGULATIONS.

1/23/86 John H. Williams Jr.
Chairman, Secretary, or Director of
Planning.
Greenville County Planning Commission

SURVEY FOR
WILLIAMSBURG AT BOTANY WOODS
HORIZONTAL PROPERTY REGIME
GREENVILLE CO. SOUTH CAROLINA

WEBB SURVEYING & MAPPING GROUP
P.O. BOX 4756 - 29608



SCALE 1" = 20 FT.
DATE DEC. 23 1985

- I HEREBY CERTIFY THE RATIO OF PERECSON OF THE FIELD SURVEY IS 1/ _____ THE AREA WAS DETERMINED BY _____ CALCULATION
- I HEREBY CERTIFY THAT THE PROPERTY LINES AND ANY IMPROVMENTS ARE CORRECT AND NO VISIBLE ENCROACHMENTS EXIST UNLESS OTHERWISE SHOWN
- THIS PROPERTY IS SUBJECT TO ANY EASEMENTS OR RIGHT OF WAYS OF RECORD OR NOT OF RECORD
- THIS _____ IS NOT WITHIN A FLOOD HAZARD AREA

NOTE - LIMITED COMMON ELEMENTS

THIS PLAT FOR RECORDING

THE PRINT MACHINE, INC. N66301