MICROFILMED

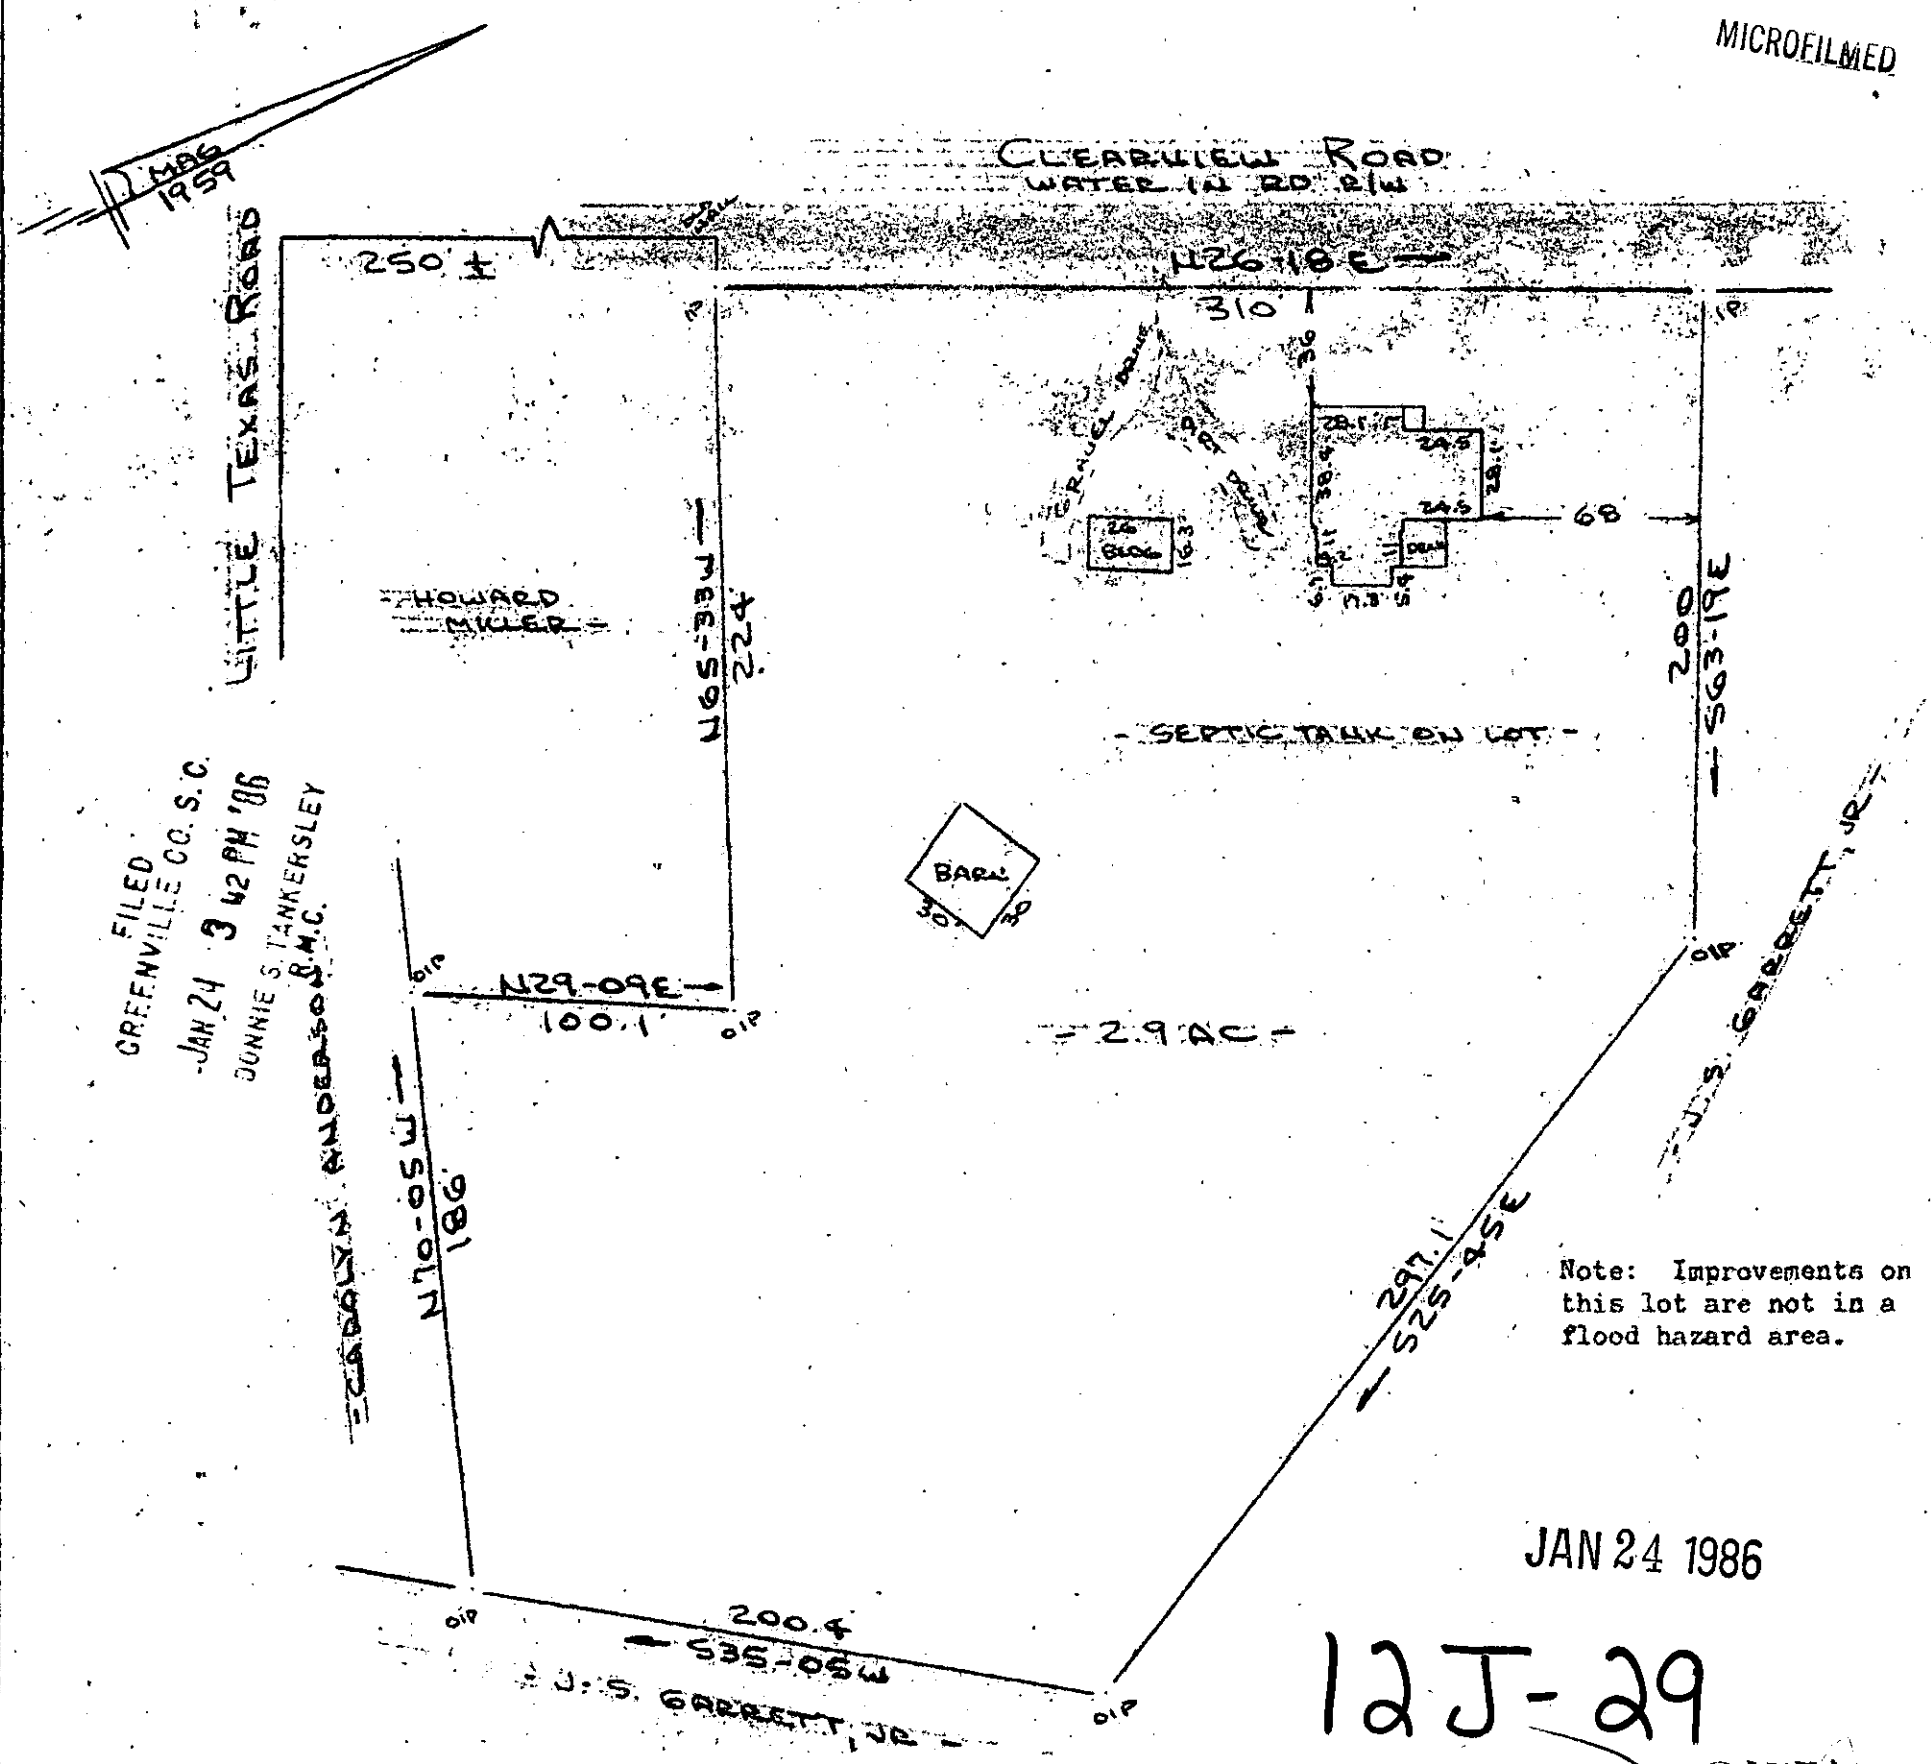

Note: Improvements on this lot are not in a flood hazard area.

JAN 24 1986

12J-29

24551

PROPERTY OF
JAMES E. MERCK & SHERRI C. MERCK
NEAR TRAVELERS REST, GREENVILLE CO., S.C.
SCALE: 1"=60' 23 JAN 1986

60 30 0 60

This is to certify that on the 23rd day of January, 1986, I surveyed the property shown on this plat, being known as 2.9 acres on plat of HOMER FERGUSON and recorded in the RMC Office Greenville County, S. C., in Plat Book " OO " at Page 236 and also being known as PROPERTY OF JAMES E. MERCK & SHERRI C. MERCK and recorded in Plat Book at Page ; and that the property lines, walls and buildings are as shown hereon, and that the walls and buildings located on said lot do not encroach or project on adjacent street or property, and that no adjacent walls or buildings encroach or project on adjacent walls or buildings encroach or project on said premises, and no power lines cross this property except as shown hereon.

R. B. Bruce

R. B. Bruce, RLS # 1952

CAROLINA SURVEYING CO.
[illegible] Only St.
Greenville, S. C.

Recordable Plat

301/10 500.5-1-9 300 3 21A01