



FILED  
 GREENVILLE CO. S. C.  
 JAN 30 2 24 PM '86  
 DONNIE S. TANKERSLEY  
 R.M.C.

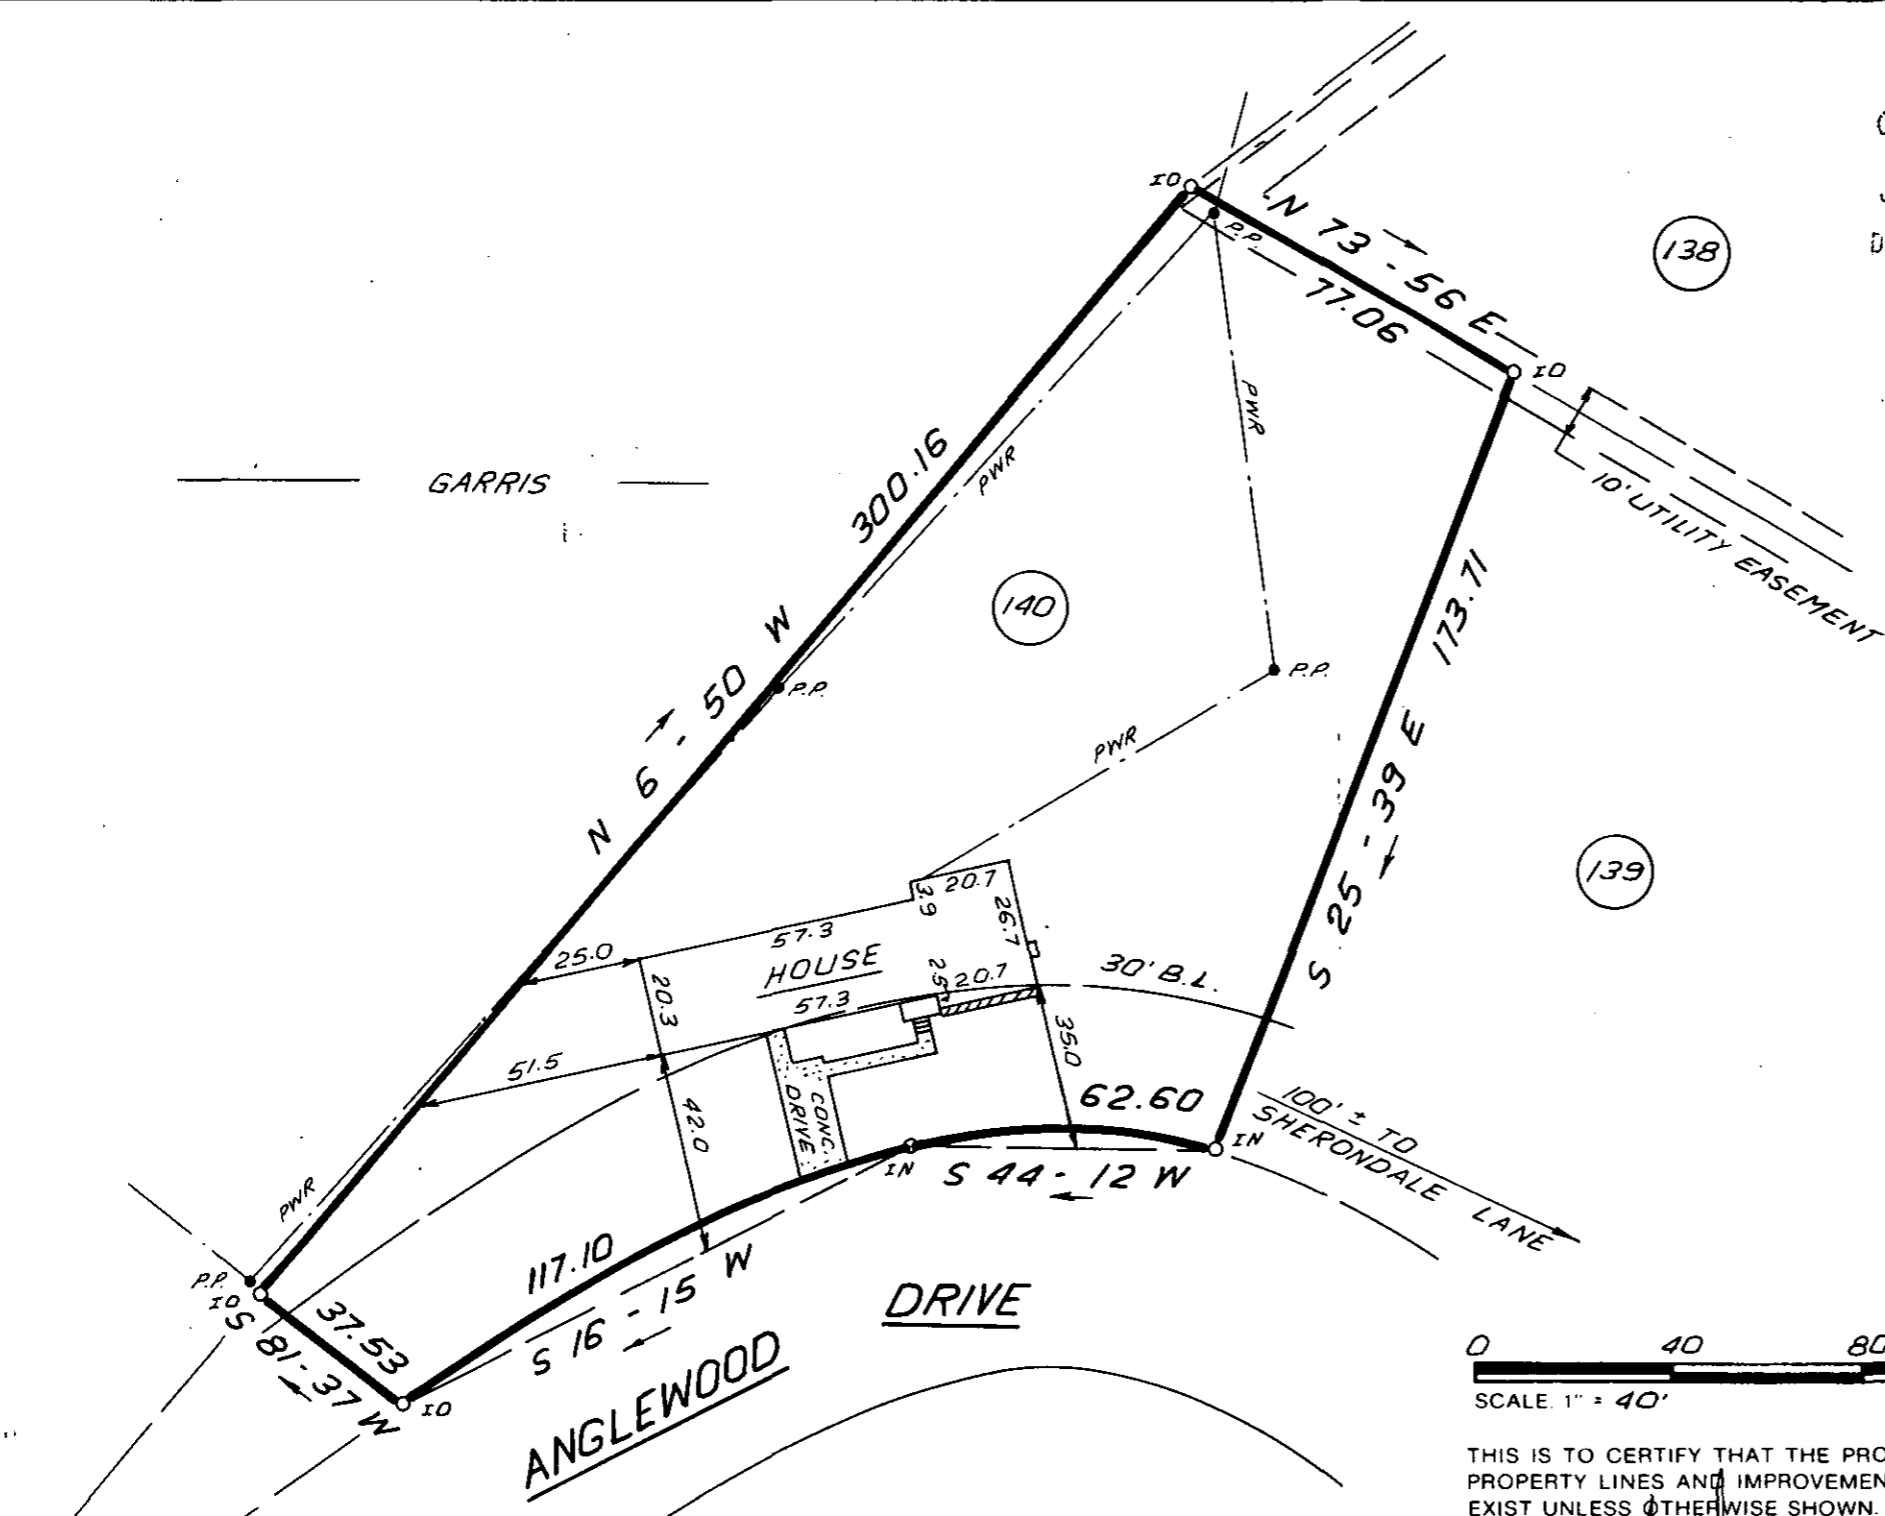


JAN 30 1986

12 J-36 ✓ 25172

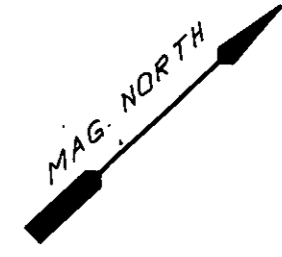

THIS IS TO CERTIFY THAT THE PROPERTY SHOWN ON THIS PLAT WAS SURVEYED UNDER MY DIRECT SUPERVISION. PROPERTY LINES AND IMPROVEMENTS SHOWN ARE LOCATED CORRECTLY AND THAT NO VISIBLE ENCROACHMENTS EXIST UNLESS OTHERWISE SHOWN. THIS PROPERTY IS NOT LOCATED IN A DESIGNATED FLOOD HAZARD AREA.

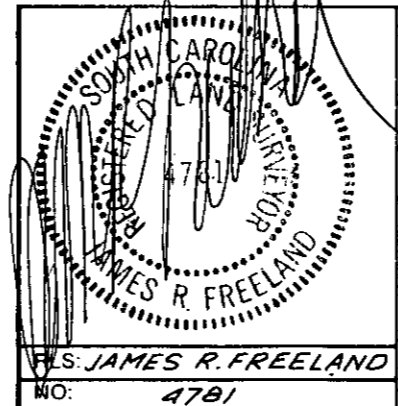

**STATE OF SOUTH CAROLINA  
 GREENVILLE COUNTY**

WESTWOOD  
SEC. 2, LOT 140  
PROPERTY OF  
SCOTT DAVID ANDRE

**FREELAND & ASSOCIATES**  
 Engineers • Land Surveyors  
 318 WEST STONE AVENUE.  
 GREENVILLE, S. C.  
 (803) 271-4924

PLAT BOOK	4F - 45
DEED BOOK	1165 - 508
TAX MAP	574.7-1-40
PARTY CHIEF	L.T.
DRAWN	I.R.
DATE	JAN - 29 - 86
DWG. NO.	14559

PLS. JAMES R. FREELAND  
 NO: 4781

0013 3 JA30 86 02