FILED
GREENVILLE CO., S.C.
FEB 5 3 48 PM '86
DONNIE S. TANKERSLEY
R.M.C.

LIVINGSTON

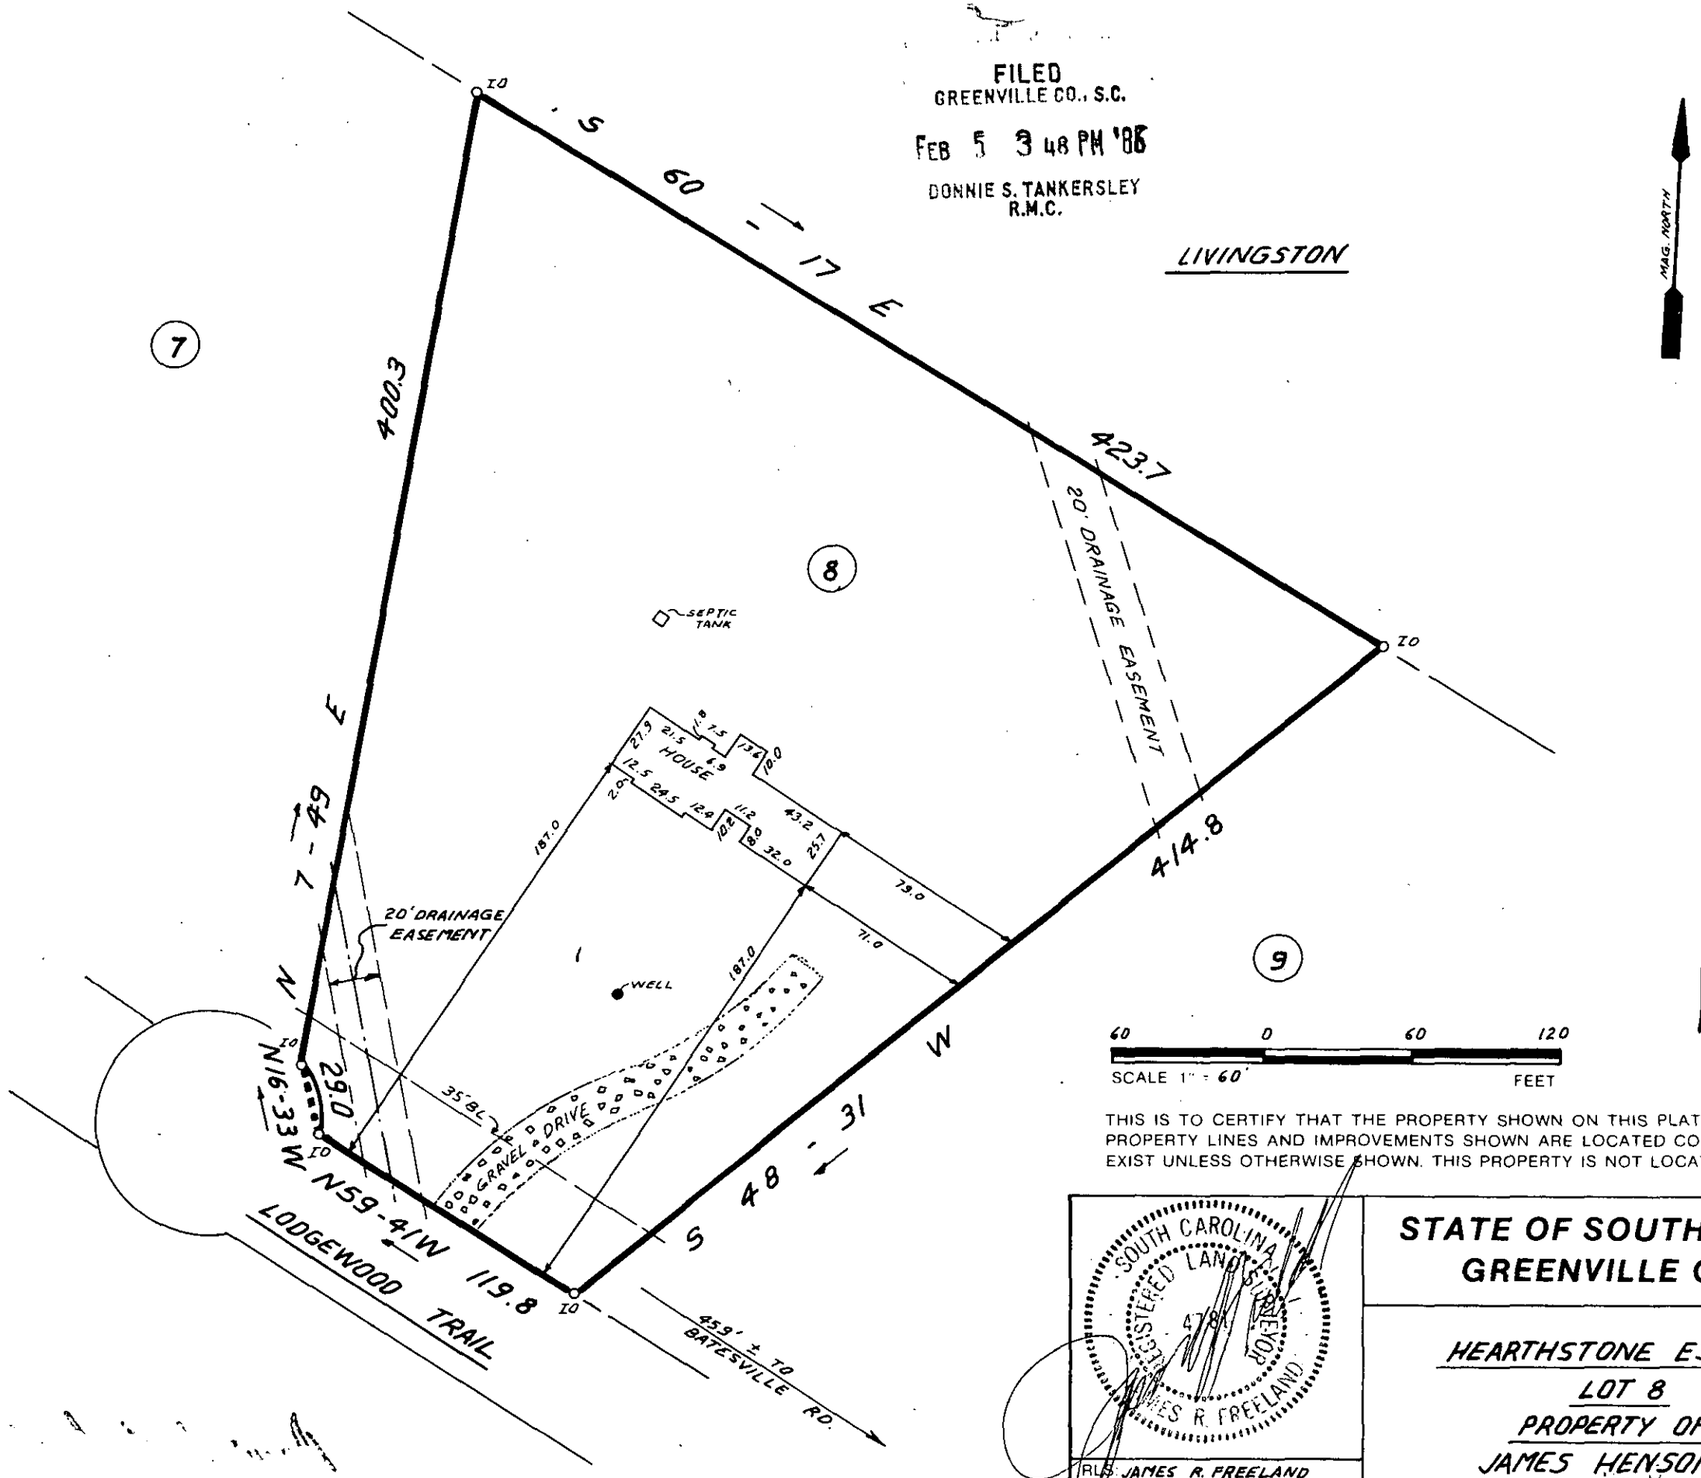

5' DRAINAGE & UTILITY EASEMENT ALONG ALL SIDE & REAR LOT LINES.

FEB 5 1986

25960

12J-48

60 0 60 120
SCALE 1" = 60' FEET

THIS IS TO CERTIFY THAT THE PROPERTY SHOWN ON THIS PLAT WAS SURVEYED UNDER MY DIRECT SUPERVISION. PROPERTY LINES AND IMPROVEMENTS SHOWN ARE LOCATED CORRECTLY AND THAT NO VISIBLE ENCROACHMENTS EXIST UNLESS OTHERWISE SHOWN. THIS PROPERTY IS NOT LOCATED IN A DESIGNATED FLOOD HAZARD AREA.

SOUTH CAROLINA REGISTERED LAND SURVEYOR 4781 JAMES R. FREELAND

RLS: JAMES R. FREELAND
NO: 4781

STATE OF SOUTH CAROLINA
GREENVILLE COUNTY

HEARTHSTONE ESTATES
LOT 8
PROPERTY OF
JAMES HENSON

FE-5 86

FREELAND & ASSOCIATES
Engineers • Land Surveyors
318 WEST STONE AVENUE.
GREENVILLE, S.C.
(803) 271-4924

PLAT BOOK	
DEED BOOK	
TAX MAP	
PARTY CHIEF	LT
DRAWN	AMG
DATE	12-19-85
DWG. NO.	14323

THE PRINT MACHINE, INC. N41289
MICROFILMED