


FILED  
GREENVILLE CO. S. C.  
APR 2 4 34 PM '86

JOHNIE S. TANKERSLEY  
R.M.C.



(5-3-8)

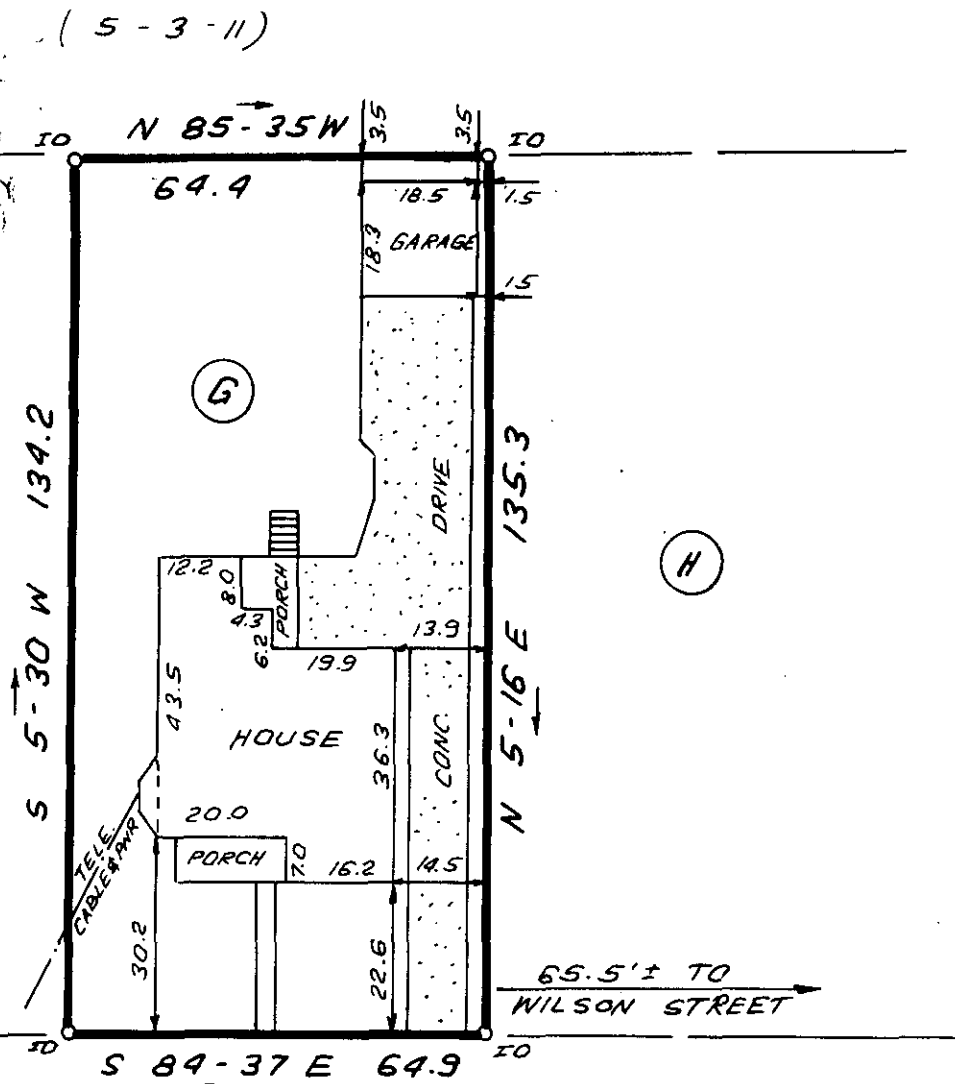

WEST EARLE STREET


APR 2 1986

12-0-21 ✓



THIS IS TO CERTIFY THAT THE PROPERTY SHOWN ON THIS PLAT WAS SURVEYED UNDER MY DIRECT SUPERVISION. PROPERTY LINES AND IMPROVEMENTS SHOWN ARE LOCATED CORRECTLY AND THAT NO VISIBLE ENCROACHMENTS EXIST UNLESS OTHERWISE SHOWN. THIS PROPERTY IS NOT LOCATED IN A DESIGNATED FLOOD HAZARD AREA

32428

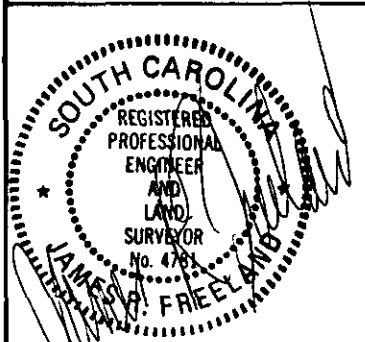

**STATE OF SOUTH CAROLINA  
GREENVILLE COUNTY**

**MOUNTAIN CITY LAND IMPROVEMENT CO**

**LOT "G", MAP 4**

**PROPERTY OF**

**JAY B. BANKS**

**REBECCA R. BANKS**

**FREELAND-CLINKSCALES & ASSOCIATES, INC.**  
 Engineers • Land Surveyors  
 323 WEST STONE AVENUE  
 GREENVILLE, S.C.  
 (803) 271-4824

PLAT BOOK	WW - 605
DEED BOOK	1145-590
TAX MAP	5-3-9
PARTY CHIEF	J.E.C.
DRAWN	I.R.
DATE	MARCH - 28 - 86
DWG NO.	14860

RLS- JAMES R. FREELAND.  
NO: 4781

2 AP 2 96 1495 3.0001