


MICROFILMED

FILED
GREENVILLE CO. S. C.
APR 3 9 57 AM '86
DONNIE S. TANKERSLEY
R.M.C.

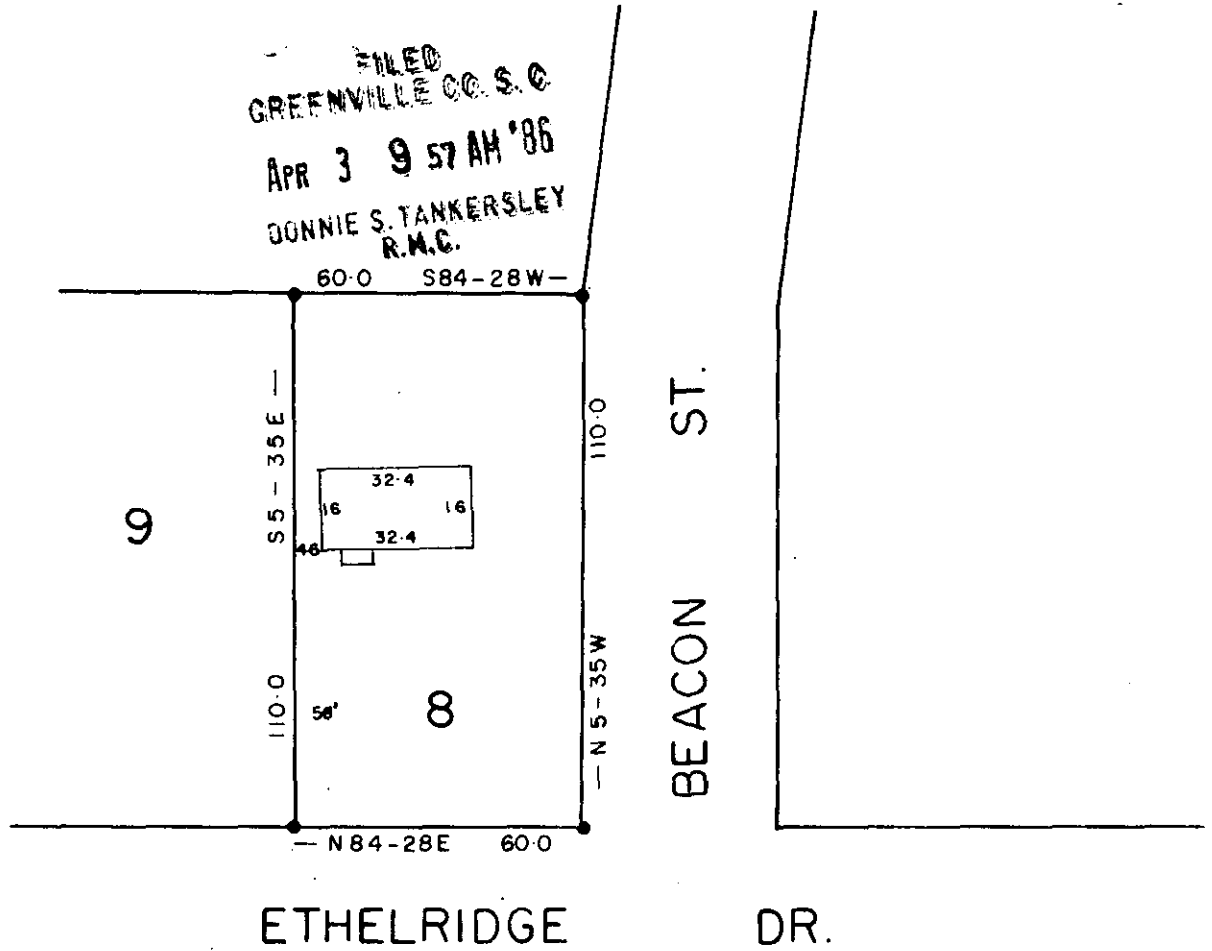




NOTE: THIS LOT DOES NOT LIE IN A FLOOD PLANE.

PROPERTY OF

LES WARD

GREENVILLE CO., S. C.

MAR. 3, 1986 SCALE 1" = 40'

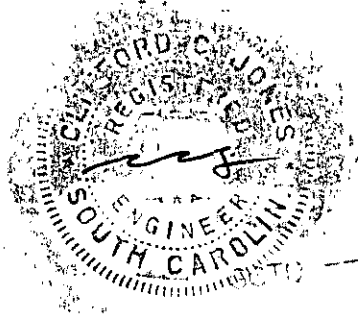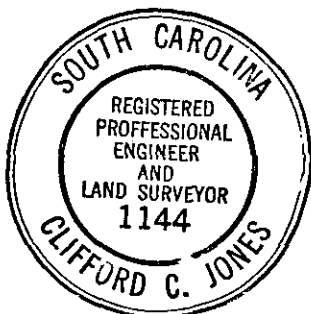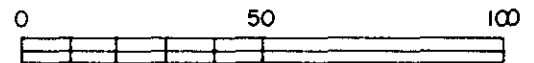

3.00CI

2 AP 3 86 150!