


78 FILED  
GREENVILLE S.C.  
APR 10 11 05 AM '86  
JONNIE S. FANKERSLEY  
R.M.C.

77

76

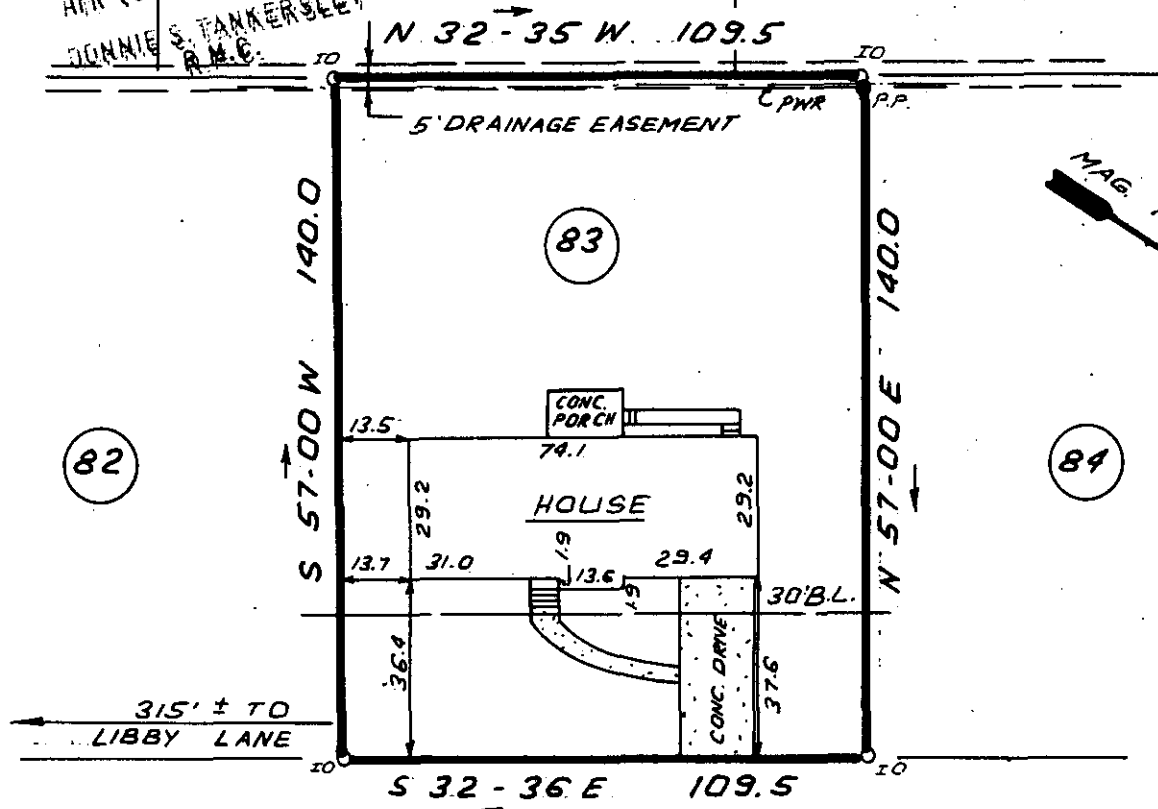

82

83

84

APR 10 1986

BASSWOOD DRIVE

✓ 12-0-45

33230



NOTE: 5' DRAINAGE EASEMENT ALONG ALL SIDE & REAR LOT LINES WHERE NEEDED.

THIS IS TO CERTIFY THAT THE PROPERTY SHOWN ON THIS PLAT WAS SURVEYED UNDER MY DIRECT SUPERVISION. PROPERTY LINES AND IMPROVEMENTS SHOWN ARE LOCATED CORRECTLY AND THAT NO VISIBLE ENCROACHMENTS EXIST UNLESS OTHERWISE SHOWN. THIS PROPERTY IS NOT LOCATED IN A DESIGNATED FLOOD HAZARD AREA.

SOUTH CAROLINA  
REGISTERED LAND SURVEYOR  
No. 478A  
JAMES R. FREELAND

RLS: JAMES R. FREELAND  
NO. 4781

**STATE OF SOUTH CAROLINA  
GREENVILLE COUNTY**

HILLSBOROUGH  
SEC. 2, LOT 83  
PROPERTY OF  
JAMES K. SULLIVAN  
BEVERLY N. SULLIVAN

**FREELAND-CLINKSCALES & ASSOCIATES, INC.**  
Engineers • Land Surveyors  
323 WEST STONE AVENUE  
GREENVILLE, S.C.  
(803) 271-4924

PLAT BOOK	4F - 51
DEED BOOK	1132 - 762
TAX MAP	M 4.5 - 1 - 90
PARTY CHIEF	J.E.C.
DRAWN	I.R.
DATE	APRIL - 7 - 86
DWG. NO	14921