


Note:  
Improvements on  
this lot are not in  
a flood hazard  
area.

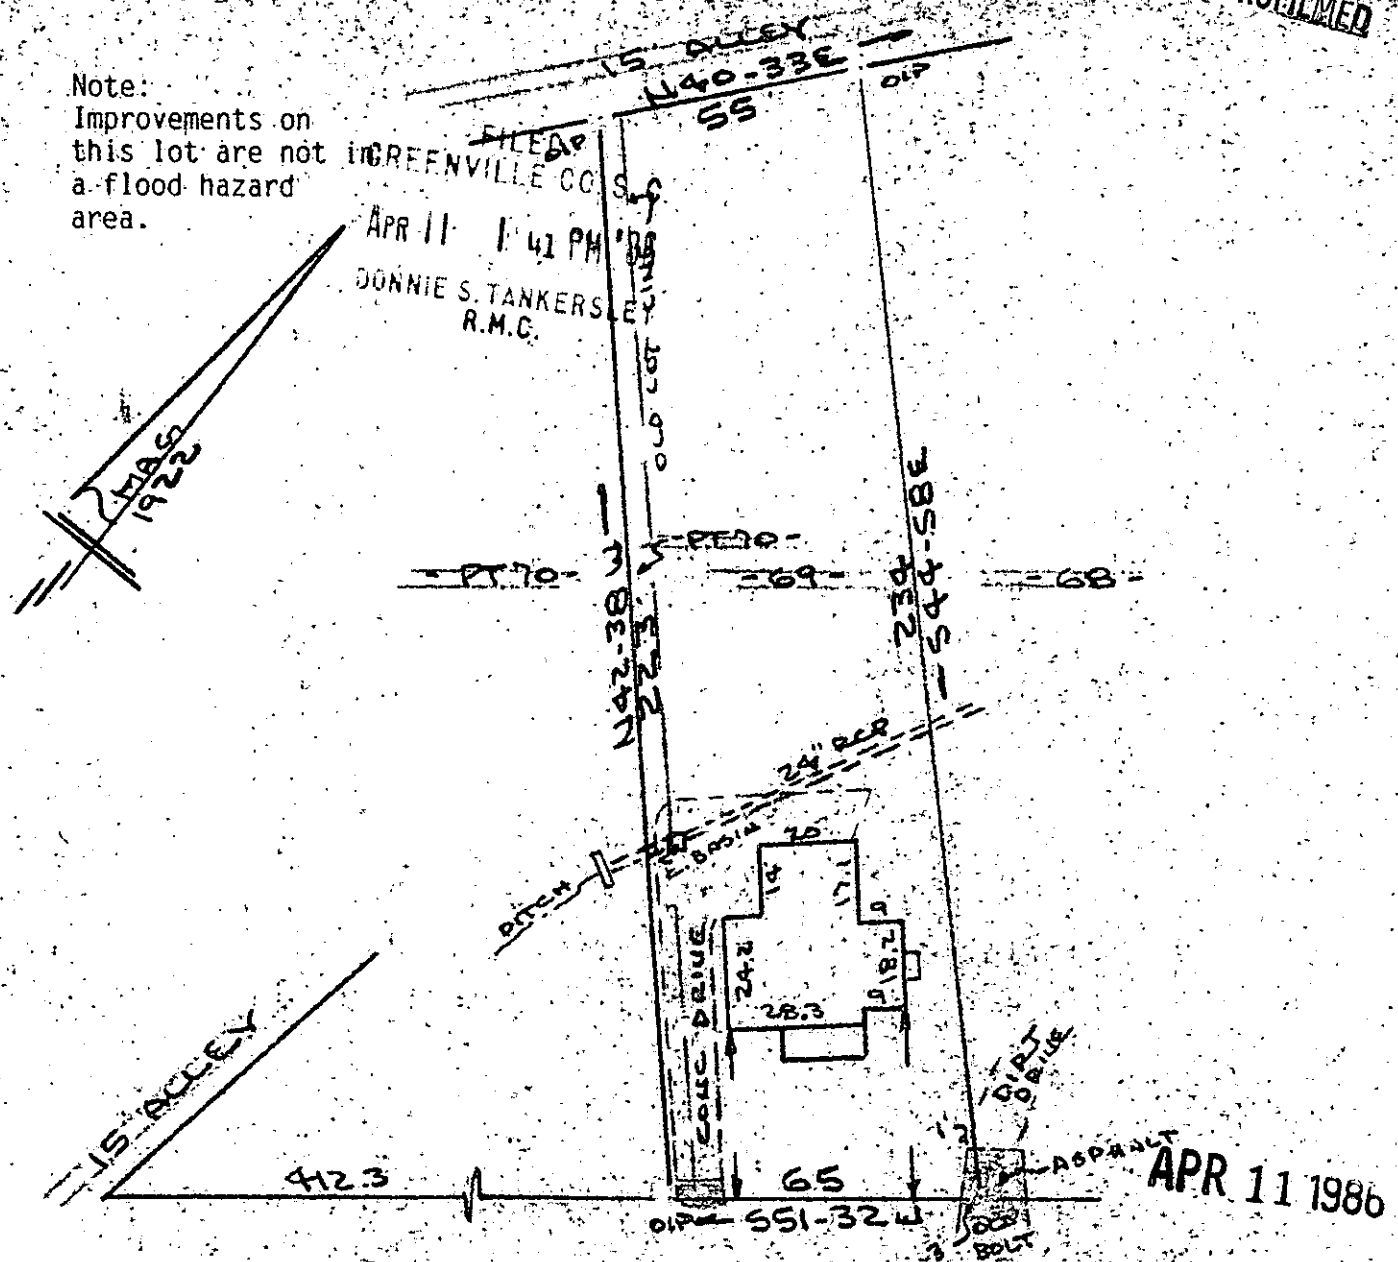

PROPERTY OF  
H. DAVID HARRELL & PATRICIA O. HARRELL

CITY OF GREENVILLE S.C. 33123

SCALE: 1" = 40' 4 APR 1986



12-0-54

This is to certify that on the 4th day of April, 1986, I surveyed the property shown on this plat, being known as lot 69 & part of lot 69 on plat of OVERBROOK and recorded in the RMC Office Greenville County, S. C., in Plat Book "H" at Page 258 and also known as PROPERTY OF H. DAVID HARRELL & PATRICIA O. HARRELL and recorded in Plat Book " " at Page ; and that the property lines, walls and buildings located on said lot do not encroach or project on adjacent street or property, and that the walls and buildings located on said lot do not encroach or project on said premises, no power lines cross this property and no visible encroachments except as shown hereon.

*R. B. [Signature]*