


Note: Improvements on this lot are not in a flood hazard area.

PROPERTY OF
GAIL Y. ROYAL
NEAR SIMPSONVILLE, GREENVILLE CO. S.C.
SCALE 1"=40' 11 APRIL 1986

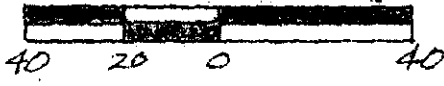

FILED
GREENVILLE CO. S.C.
APR 18 9 54 AM '86
DANNIE S. TANKERSLEY
M.C.

This is to certify that on the 11th day of April, 1986, I surveyed the property shown on this plat, being known as lot 67 on plat of SEC... TWO WEMBERLY WAY and recorded in the RMC Office Greenville County, S. C. in Plat Book " 7 - C " at Page 39; and that the property lines, walls and buildings are as shown hereon, and that the walls and buildings located on said lot do not encroach or project on adjacent street or property, and that no adjacent walls or buildings encroach or project on said premises, no power lines cross this property and no visible encroachments except as shown hereon.

12-0-83

34274

R. B. Bruce
R. B. Bruce, R.L.S. 3952

R. B. Bruce

CAROLINA SURVEYING CO.
112 Manly St.
Greenville, S. C.



Recordable Plat