


FILED
 GREENVILLE CO. S. C.
 APR 22 9 29 AM '86
 BONNIE S. TANKERSLEY
 R.M.C.

Improvements
 on this lot
 are not in a flood
 hazard area.

WEST TALLULAH DRIVE
 WATER & SEWER IN ST. RW.

PROPERTY OF
 DOUGLAS C. KEIR & LOUISE L. KEIR
 NEAR GREENVILLE, GREENVILLE, CO. S.C.
 SCALE: 1" = 40' 11 APRIL, 1986

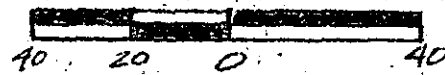


APR 22 1986

This is to certify that on the 11th day of April, 1986, I surveyed the property shown on this plat, being known as lot 17 on plat of R. E. GREGORY & CO. and recorded in the RMC Office Greenville County, S. C., in Plat Book " 5 - T. " at Page 60; and that the property lines, walls and buildings are as shown hereon, and that the walls and buildings located on said lot do not encroach or project on adjacent street or property, and that no adjacent walls or buildings encroach or project on said premises, no power lines cross this property and no visible encroachments except as shown hereon.

12-0-99
 34655

R. B. Bruce
 R. B. Bruce, RLS # 21952
 R. B. Bruce

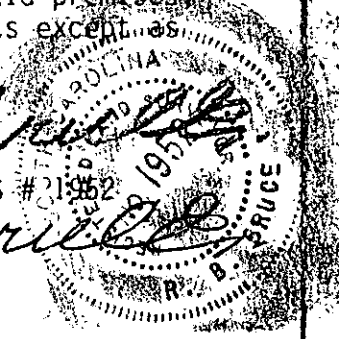

CAROLINA SURVEYING CO.
 112 Manly St.
 Greenville, S. C.

Recordable Plat

300 3 11A91