
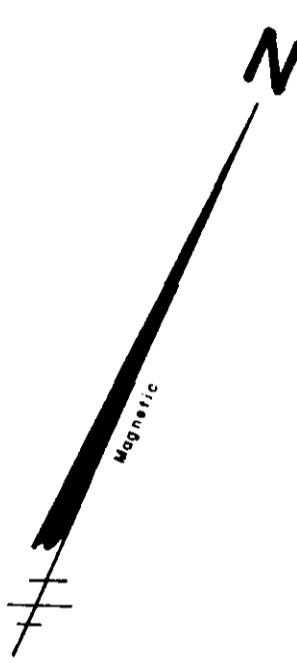


Note:

This is Lots 26, 27 Of The Goddard - McPherson Property, Deed Book 1127 - Page 752

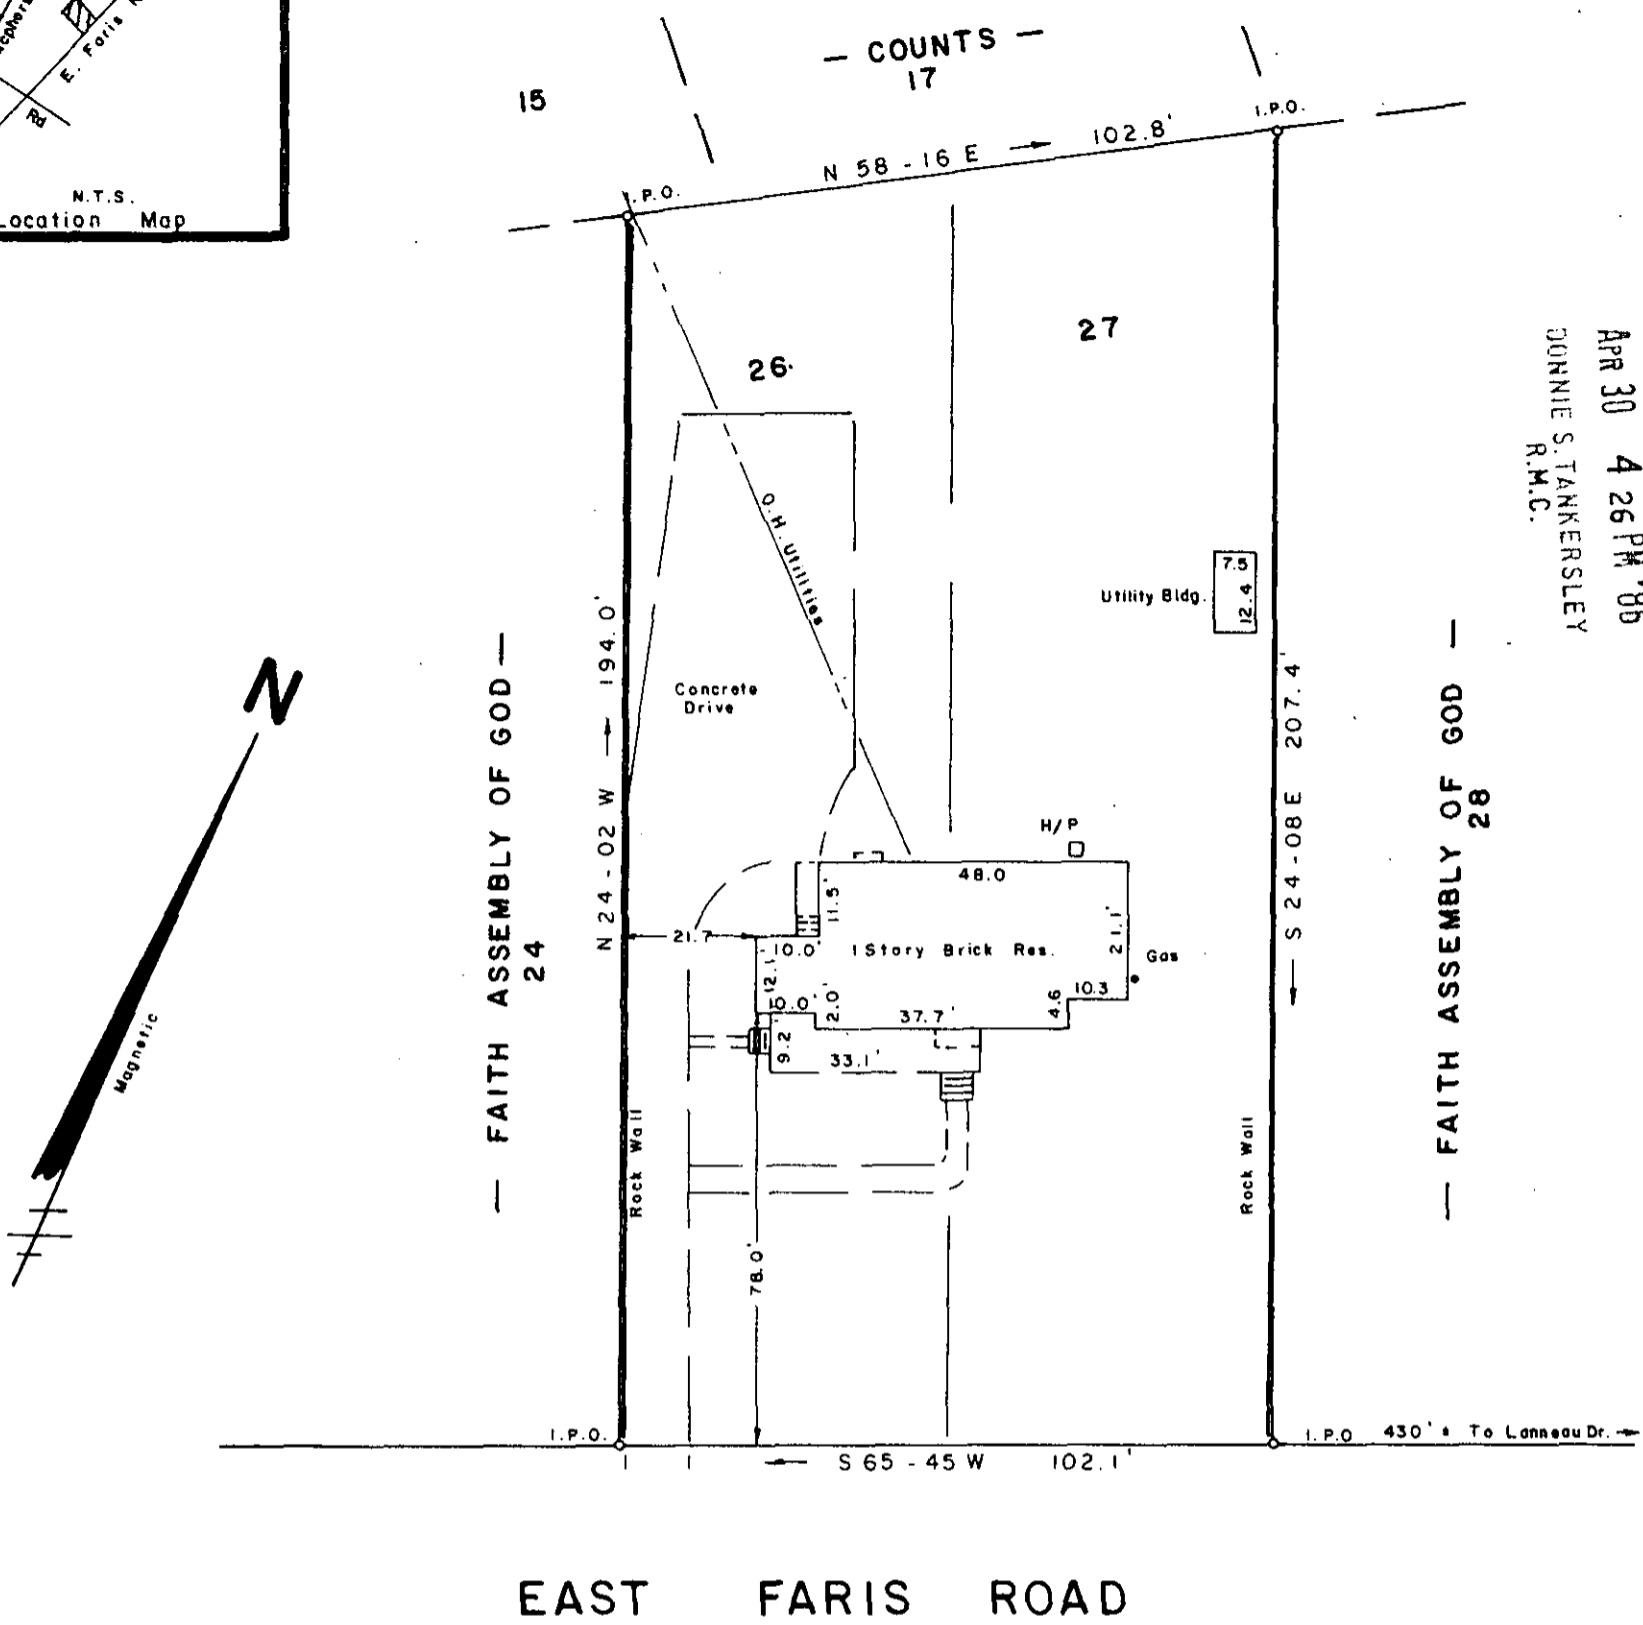

SURVEY FOR

JOYCE V. COMPTON

CITY OF GREENVILLE

GREENVILLE COUNTY

SOUTH

CAROLINA

APRIL

22,

1986

APR 30 1986

35817

12-R-17

To The Best Of My Knowledge This Structure Is Not In An Established Flood Zone.

I Herby Certify That The Measurements As Shown Above Are Correct And There Are No Encroachments Or Projections Other Than Shown.

I Herby Certify That The Ratio Of Precision Of The Field Survey Is 1/5000 As Shown Hereon And The Area Was Determined By Computer.

Jeffery M. Plumblee

REGISTRAR

PL 7881

SURVEYOR



JEFFERY M. PLUMBLEE, INC.
LAND SURVEYING

P. O. BOX 788
TRAVELERS REST, S. C. 29690

(803) 834-4426

203 - 9 - 65

F. B. 36

5.00 3

11A01