



FILED
GREENVILLE CO. S. C.
MAY 12 1 21 PM '86
JONNIE S. TANKERSLEY
R.M.C.

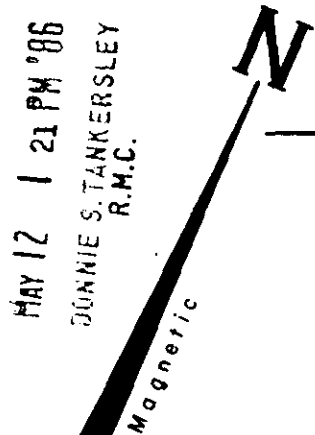

LACONIA

DRIVE

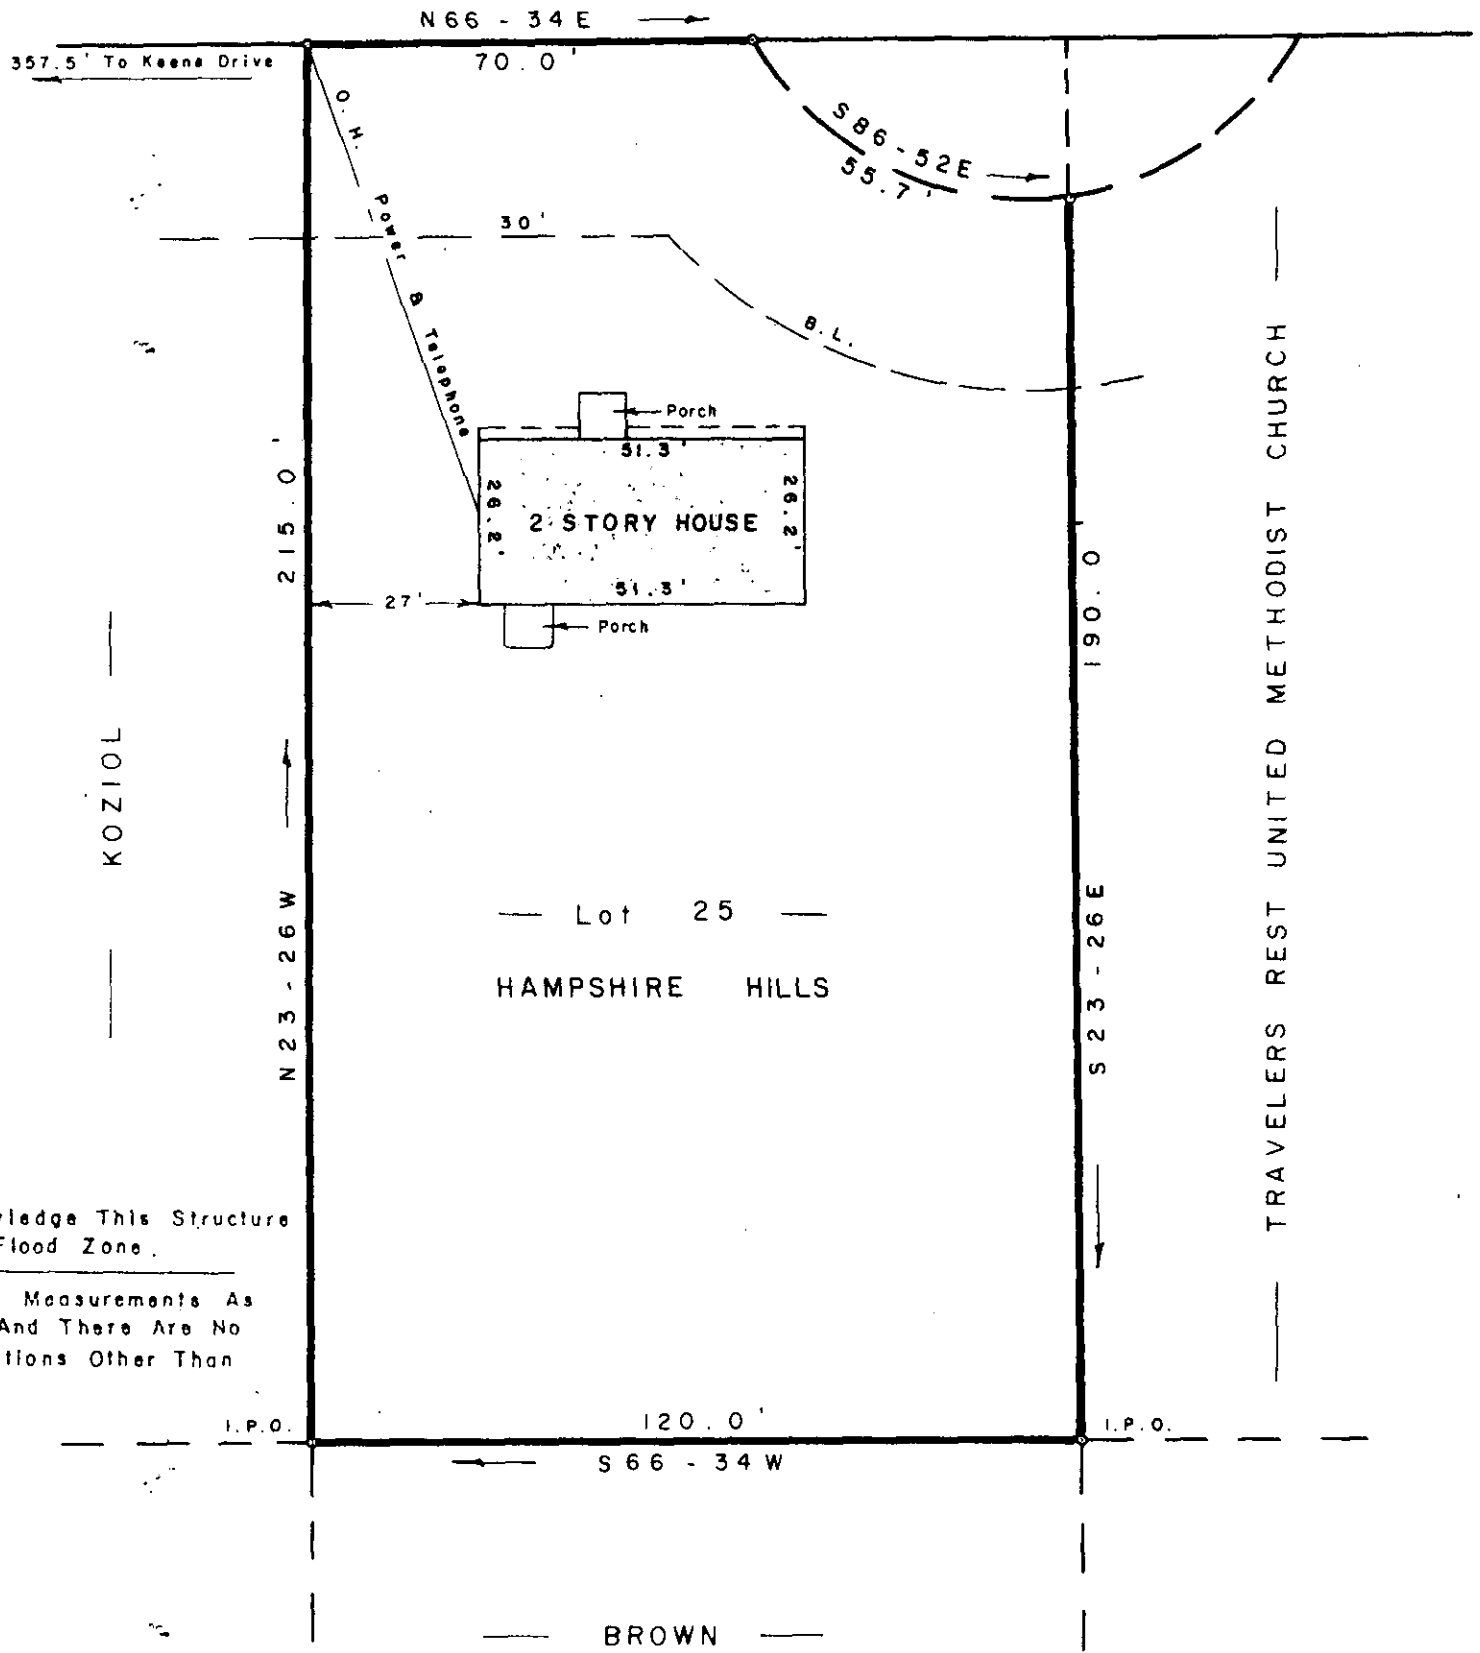

To The Best Of My Knowledge This Structure Is Not In An Established Flood Zone.

I Hereby Certify That The Measurements As Shown Above Are Correct And There Are No Encroachments Or Projections Other Than Shown.

SURVEY FOR
RALPH C. BUCHANAN
RUTH M. BUCHANAN
 NEAR TRAVELERS REST GREENVILLE CO.
 SOUTH CAROLINA


MAY 12 1986

12-R-48

MAY 6, 1986

37313

SCALE: 1" = 30'

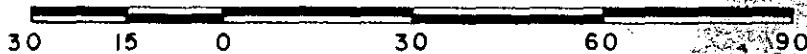

WRW

W. R. WILLIAMS, JR.
ENGINEER/SURVEYOR
P. E. & L. S. No. 3979
15 S. MAIN STREET
TRAVELERS REST, S. C.
29690

I hereby certify that the ratio of precision of the field survey is 1/5000 as shown hereon and the area was determined by D.M.D. method of area calculation.

W. R. Williams, Jr.
W. R. Williams, Jr.

P. E. & L. S. No. 3979