


MICROFILMED

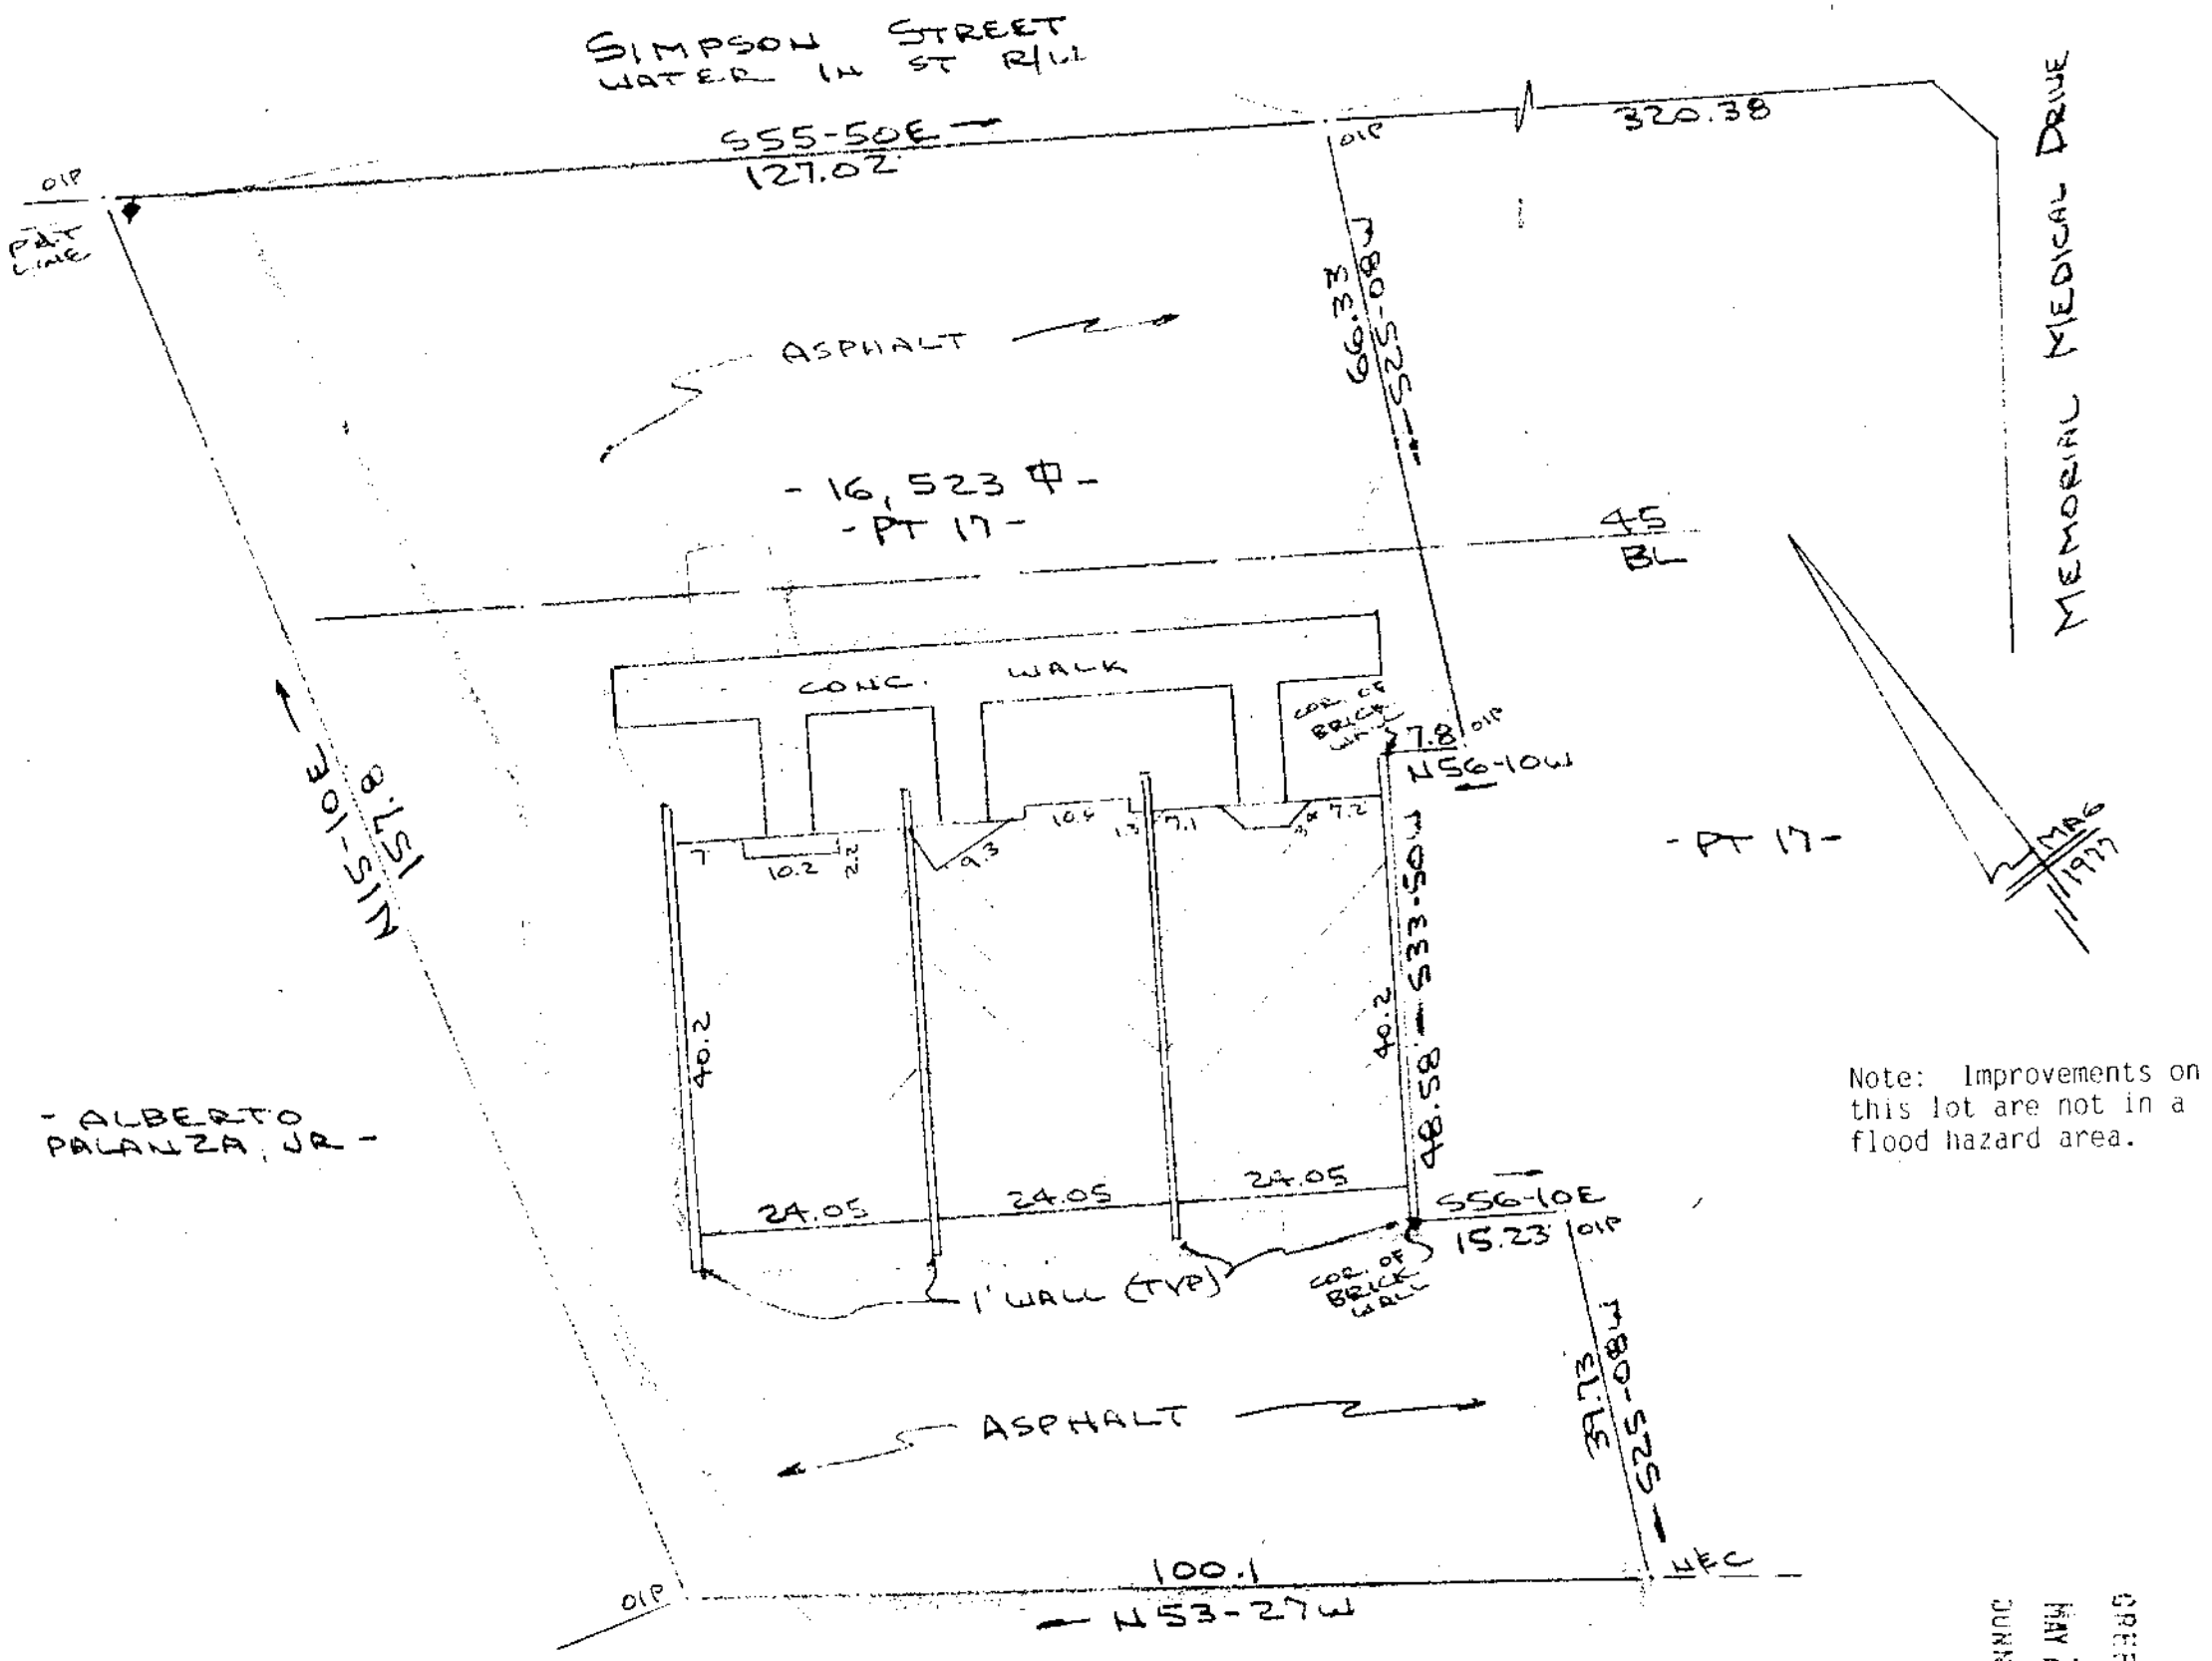

- ALBERTO PALANZA, JR -

Note: Improvements on this lot are not in a flood hazard area.

- GREENVILLE MEDICAL CORP -


PROPERTY OF
C. DAVID HILL, JR
 NEAR GREENVILLE, GREENVILLE CO., S.C.
 SCALE: 1"=20' 21 MAY 1986

FILED
 GREENVILLE CO. S.C.
 MAY 22 12 29 PM '86
 JENNIE S. TANKERSLEY
 R.M.C.

This is to certify that on the 21st day of May, 1986, I surveyed the property shown on this plat, being known as part of lot 17 on plat of MEMORIAL MEDICAL PARK and recorded in the RMC Office Greenville County, S. C., in Plat Book "5 - P" at Page 100 and also known as PROPERTY OF C. DAVID HILL, JR. and recorded in Plat Book at Page ; and that the property lines, walls and buildings are as shown hereon, and that the walls and buildings located on said lot do not encroach or project on adjacent street or property, and that no adjacent walls or buildings encroach or project on said premises, no power lines cross this property and no visible encroachments except as shown hereon.

12-R-75 38736
 MAY 20 1986

R. B. Bruce
 R. B. Bruce, S.

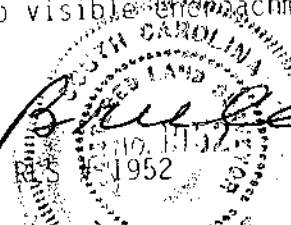

Recordable Plat

CAROLINA SURVEYING CO.
 112 Manly St.
 Greenville, S. C.

5.00CI

102-2-395

2 MY22'86 1101