


Note: Improvements on this lot are not in a flood hazard area.



BRYSON ST. (CAROLINA AVE.)  
WATER & SEWER IN ST. RW.

PROPERTY OF  
JAMES E. GRIFFITH JR. & CATHERINE ANN GRIFFITH  
GREENVILLE S.C.  
SCALE 1" = 40' 16 APRIL 1986

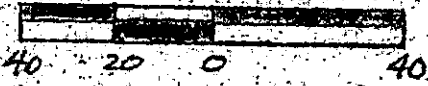

MAY 12 1986

This is to certify that on the 16th day of April, 1986, I surveyed the property shown on this plat, being known as lot 15 on plat of HIGHLAND and recorded in the RMC Office Greenville County, S. C., in Plat Book " C " at Page 146; and that the property lines, walls and buildings are as shown hereon, and that the walls and buildings located on said lot do not encroach or project on adjacent street or property, and that no adjacent walls or buildings encroach or project on said premises, no power lines cross this property and no visible encroachments except as shown hereon.

12-S-43  
 R. B. Bruce  
 R. B. Bruce  
 37316  
 R. B. Bruce, RLS # 1952



CAROLINA SURVEYING CO.  
112 Manly St.  
Greenville, S. C.

Recordable Plat