


FILED
GREENVILLE CO. S. C.

JUL 16 1 38 PM '86

DONNIE S. TANKERSLEY
R.M.C.

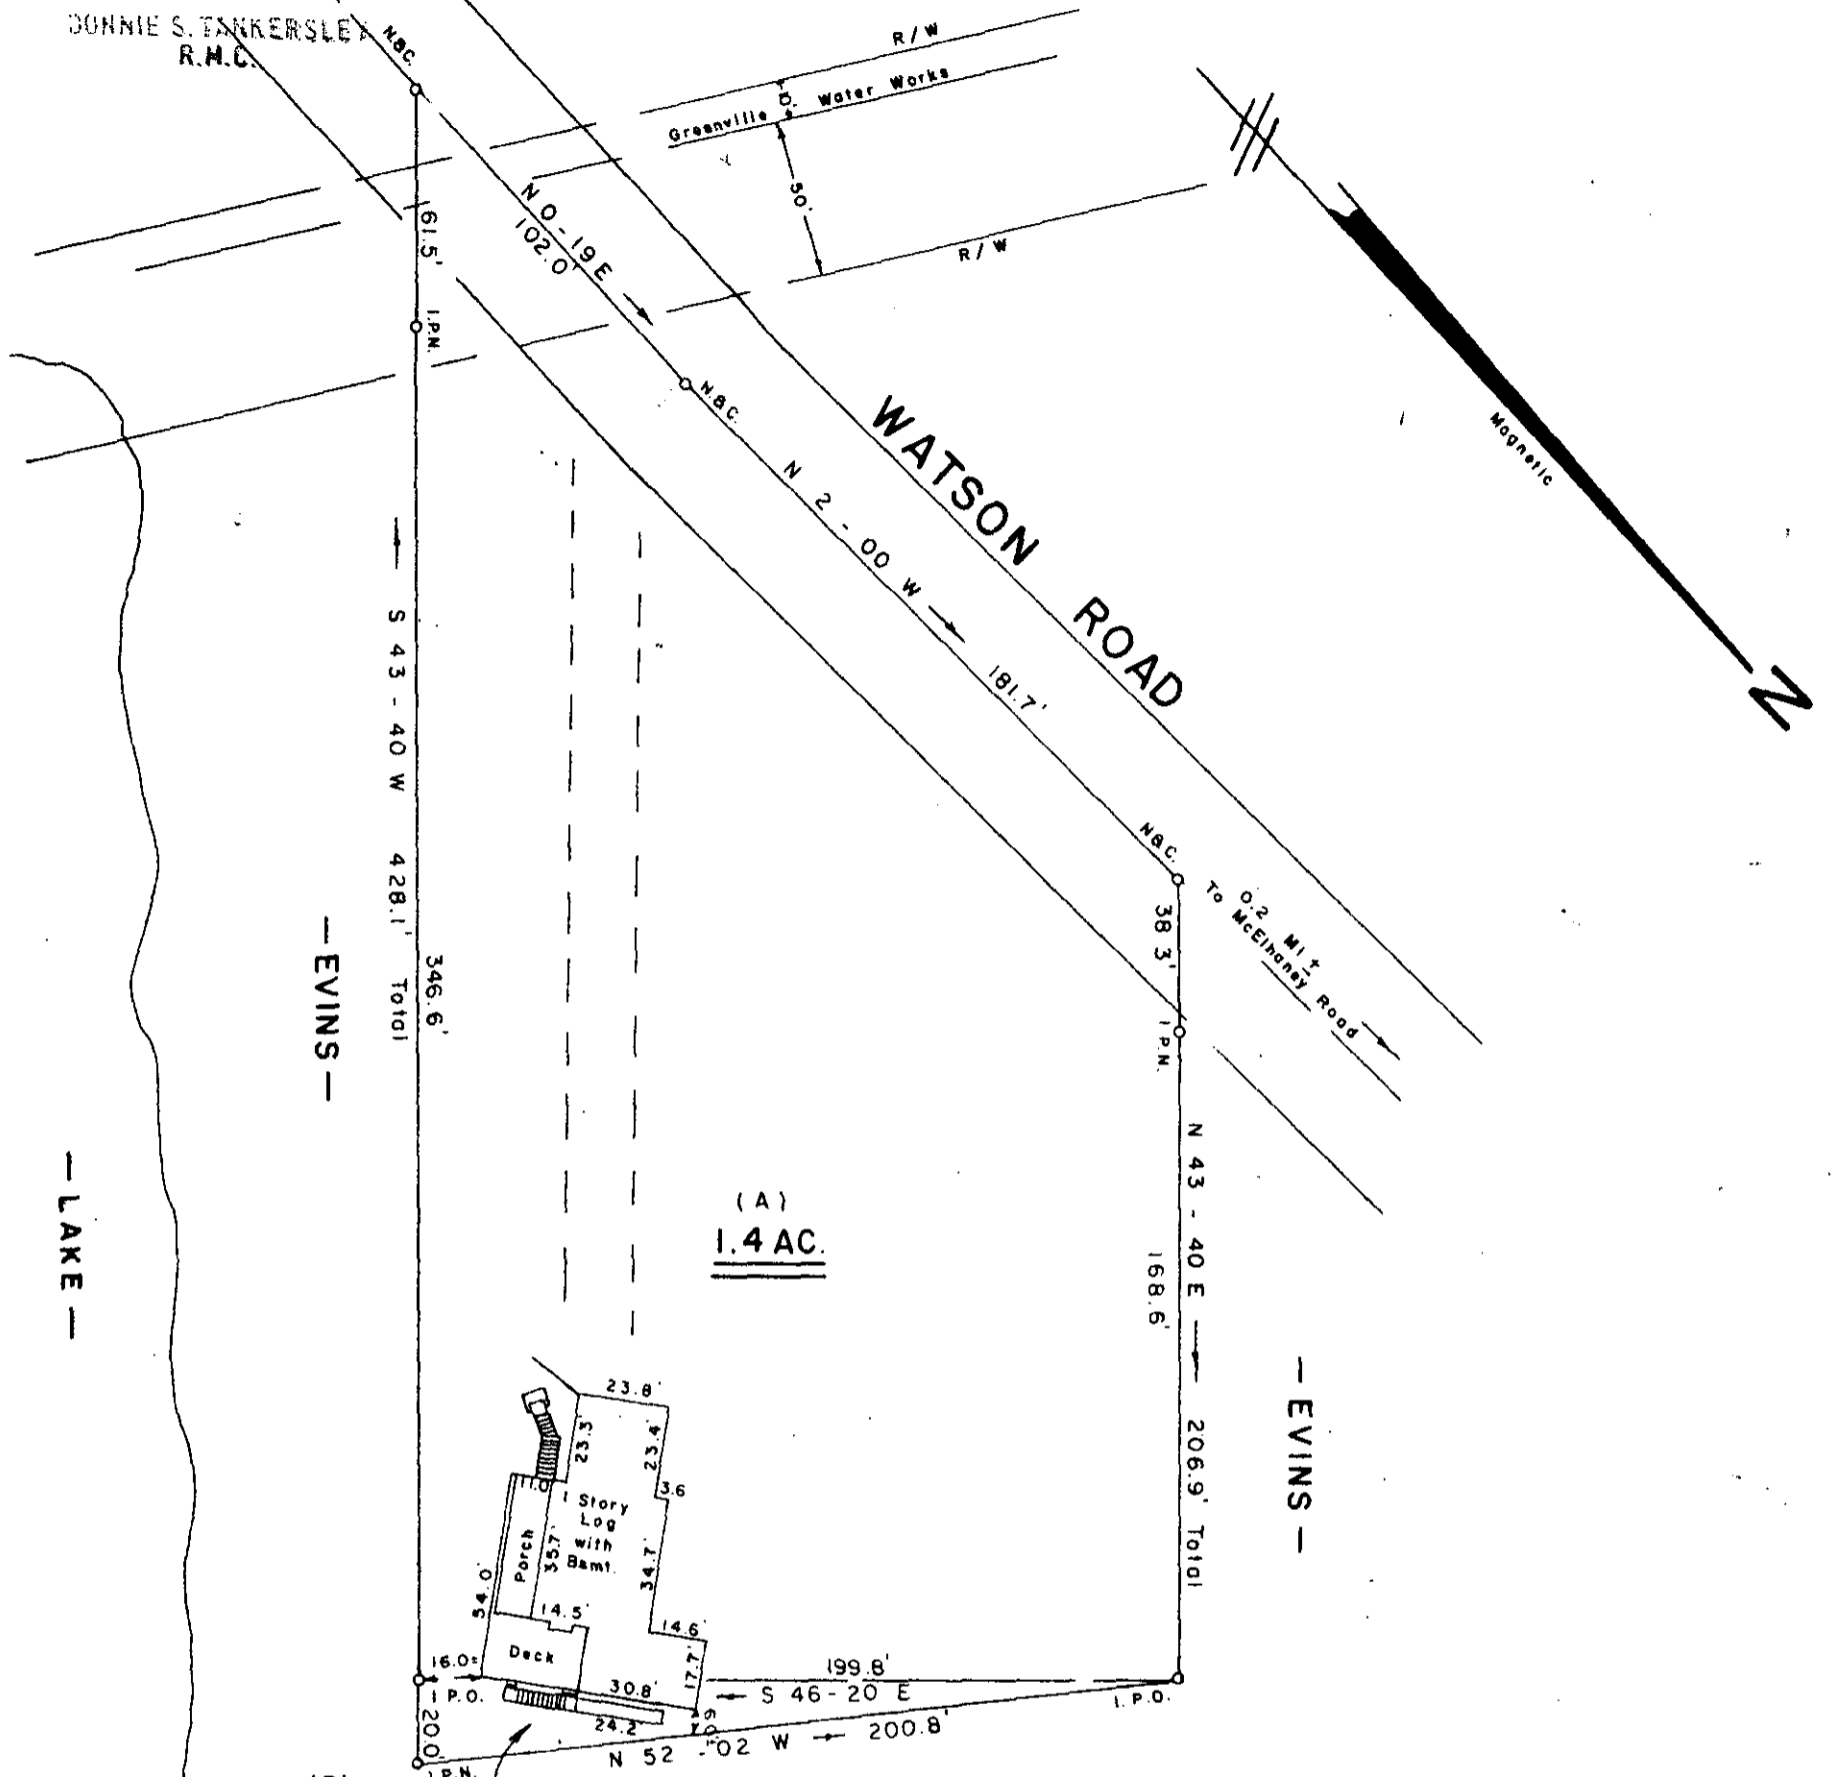

SURVEY FOR
GREGORY G. EVINS
SHARON B. EVINS
 CITY OF TRAVELERS REST GREENVILLE COUNTY

SOUTH CAROLINA
 AUGUST 13, 1985
 REVISED FEBRUARY 18, 1986
 REVISED JULY 15, 1986

V 2336
12-2-1

Note: Tracts A And B To Be Combined.


JUL 16 1986

To The Best Of My Knowledge This Structure Is Not In An Established Flood Zone.

I Hereby Certify That The Measurements As Shown Above Are Correct And There Are No Encroachments Or Projections Other Than Shown

I Hereby Certify That The Ratio Of Precision Of The Field Survey Is 1/5000 As Shown Hereon And The Area Was Determined By Computer.

Jeffery M. Plumblee
 P. L. S. # 7881

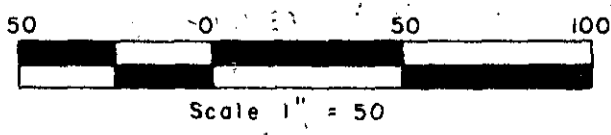

JEFFERY M. PLUMBLEE, INC.
 LAND SURVEYING

P. O. BOX 788
 TRAVELERS REST, S. C. 29690 (803) 834-4426

SC10 1 JUL 16 1986 119 5.00CD