

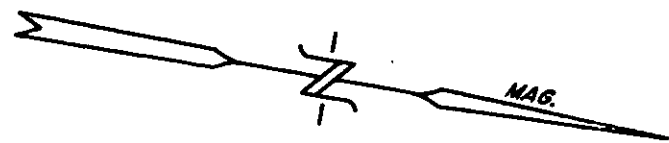


MICROFILMED

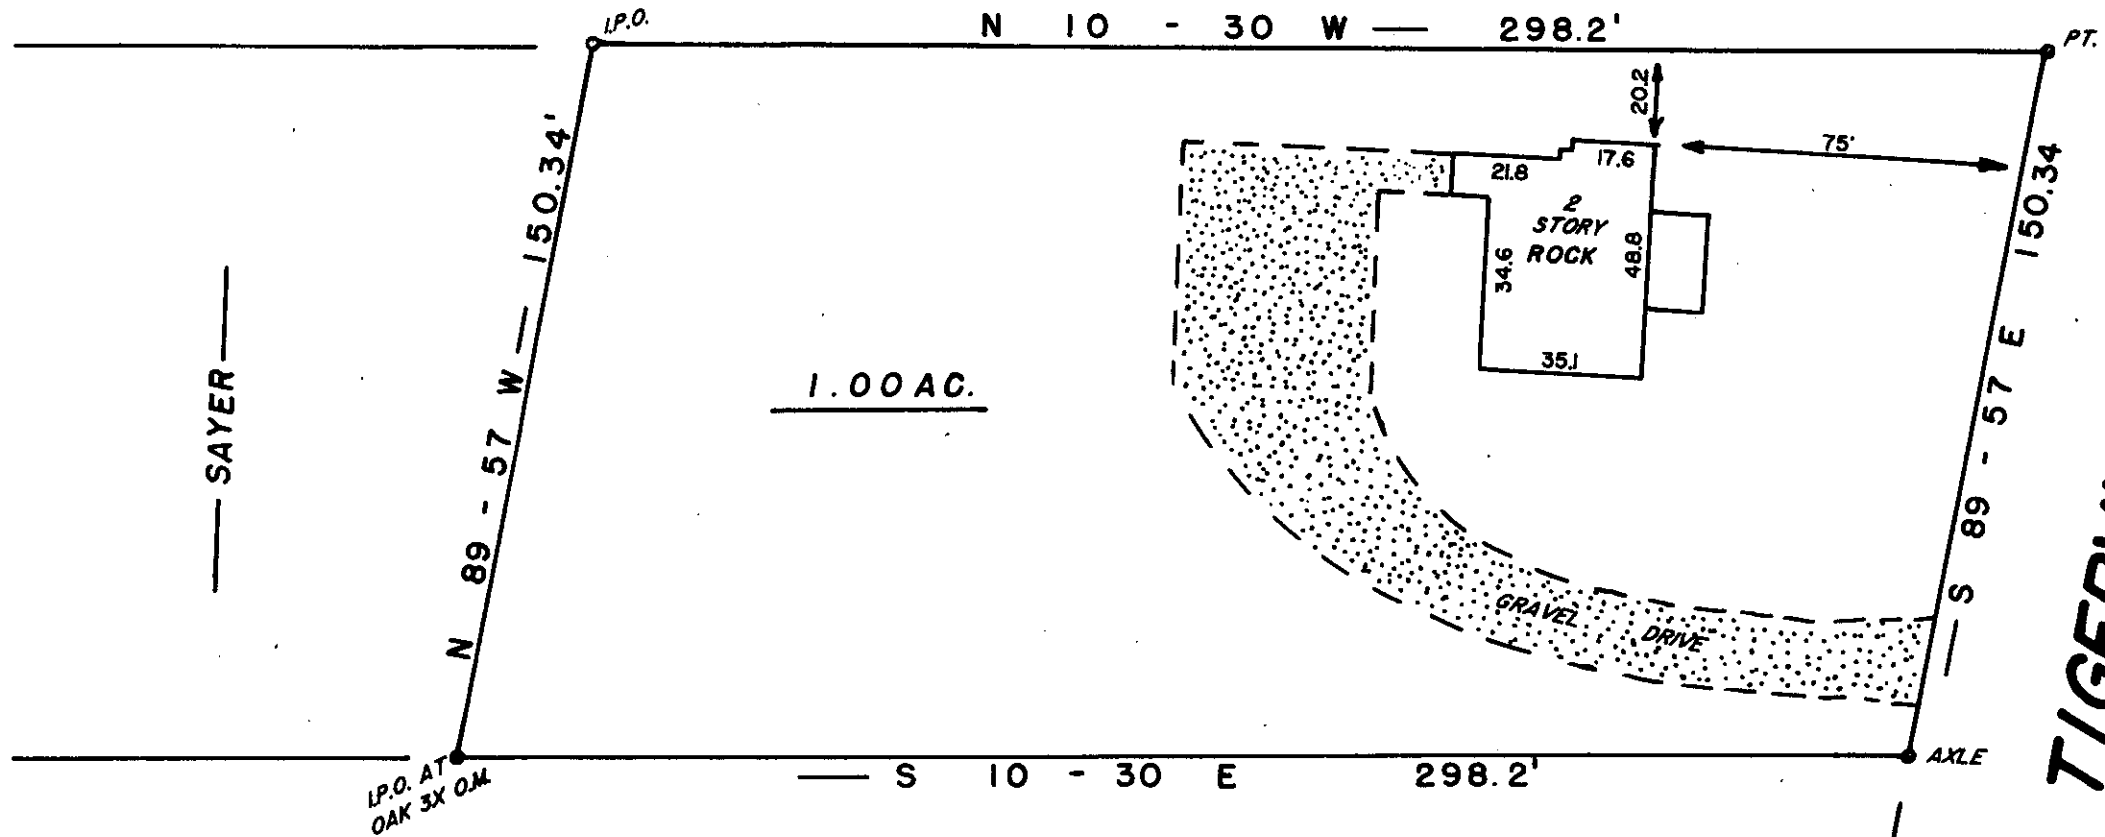

HART

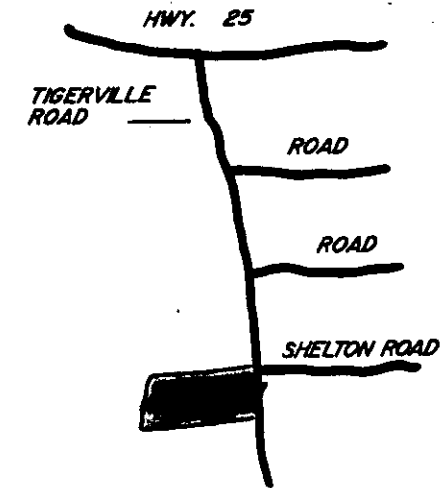

TIGERVILLE ROAD

FILED  
GREENVILLE CO. S.C.  
JUL 21 12 19 PM '86  
DONNIE S. TANKERSLEY  
R.M.C.

I.P.O. AT  
OAK 3X O.M.


ALEXANDER

122.14


2928

SURVEY FOR  
**W. CARROLL HUFF**  
**OLLIE A. HUFF**  
GREENVILLE CO. SOUTH CAROLINA

WEBB SURVEYING & MAPPING GROUP  
P.O. BOX 4756 - 29608

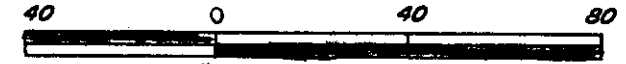

SCALE 1" = 40 FT.  
DATE JUNE 1986

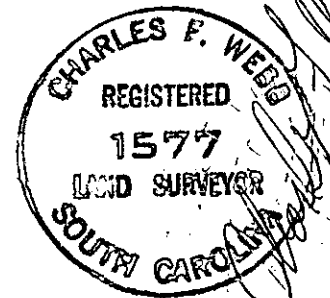

- I HEREBY CERTIFY THE RATIO OF PERECSON OF THE FIELD SURVEY IS 1/ 7500 THE AREA WAS DETERMINED BY DND CALCULATION
- I HEREBY CERTIFY THAT THE PROPERTY LINES AND ANY IMPROVMENTS ARE CORRECT AND NO VISIBLE ENCROACHMENTS EXIST UNLESS OTHERWISE SHOWN
- THIS PROPERTY IS SUBJECT TO ANY EASEMENTS OR RIGHT OFWAYS OF RECORD OR NOT OF RECORD
- THIS PRO. IS NOT WITHIN A FLOOD HAZARD AREA

REF. DEED BOOK 1063 PAGE 339

B.B.R. 5013 - 1 - 21

500 8 313+801  
5-1471

THE PRINT MACHINE, INC. N72651