


MICROFILMED




FILED
 GREENVILLE CO. S. C.
 JUL 22 11 11 AM '86
 DONNIE S. TANKERSLEY
 R.M.C.

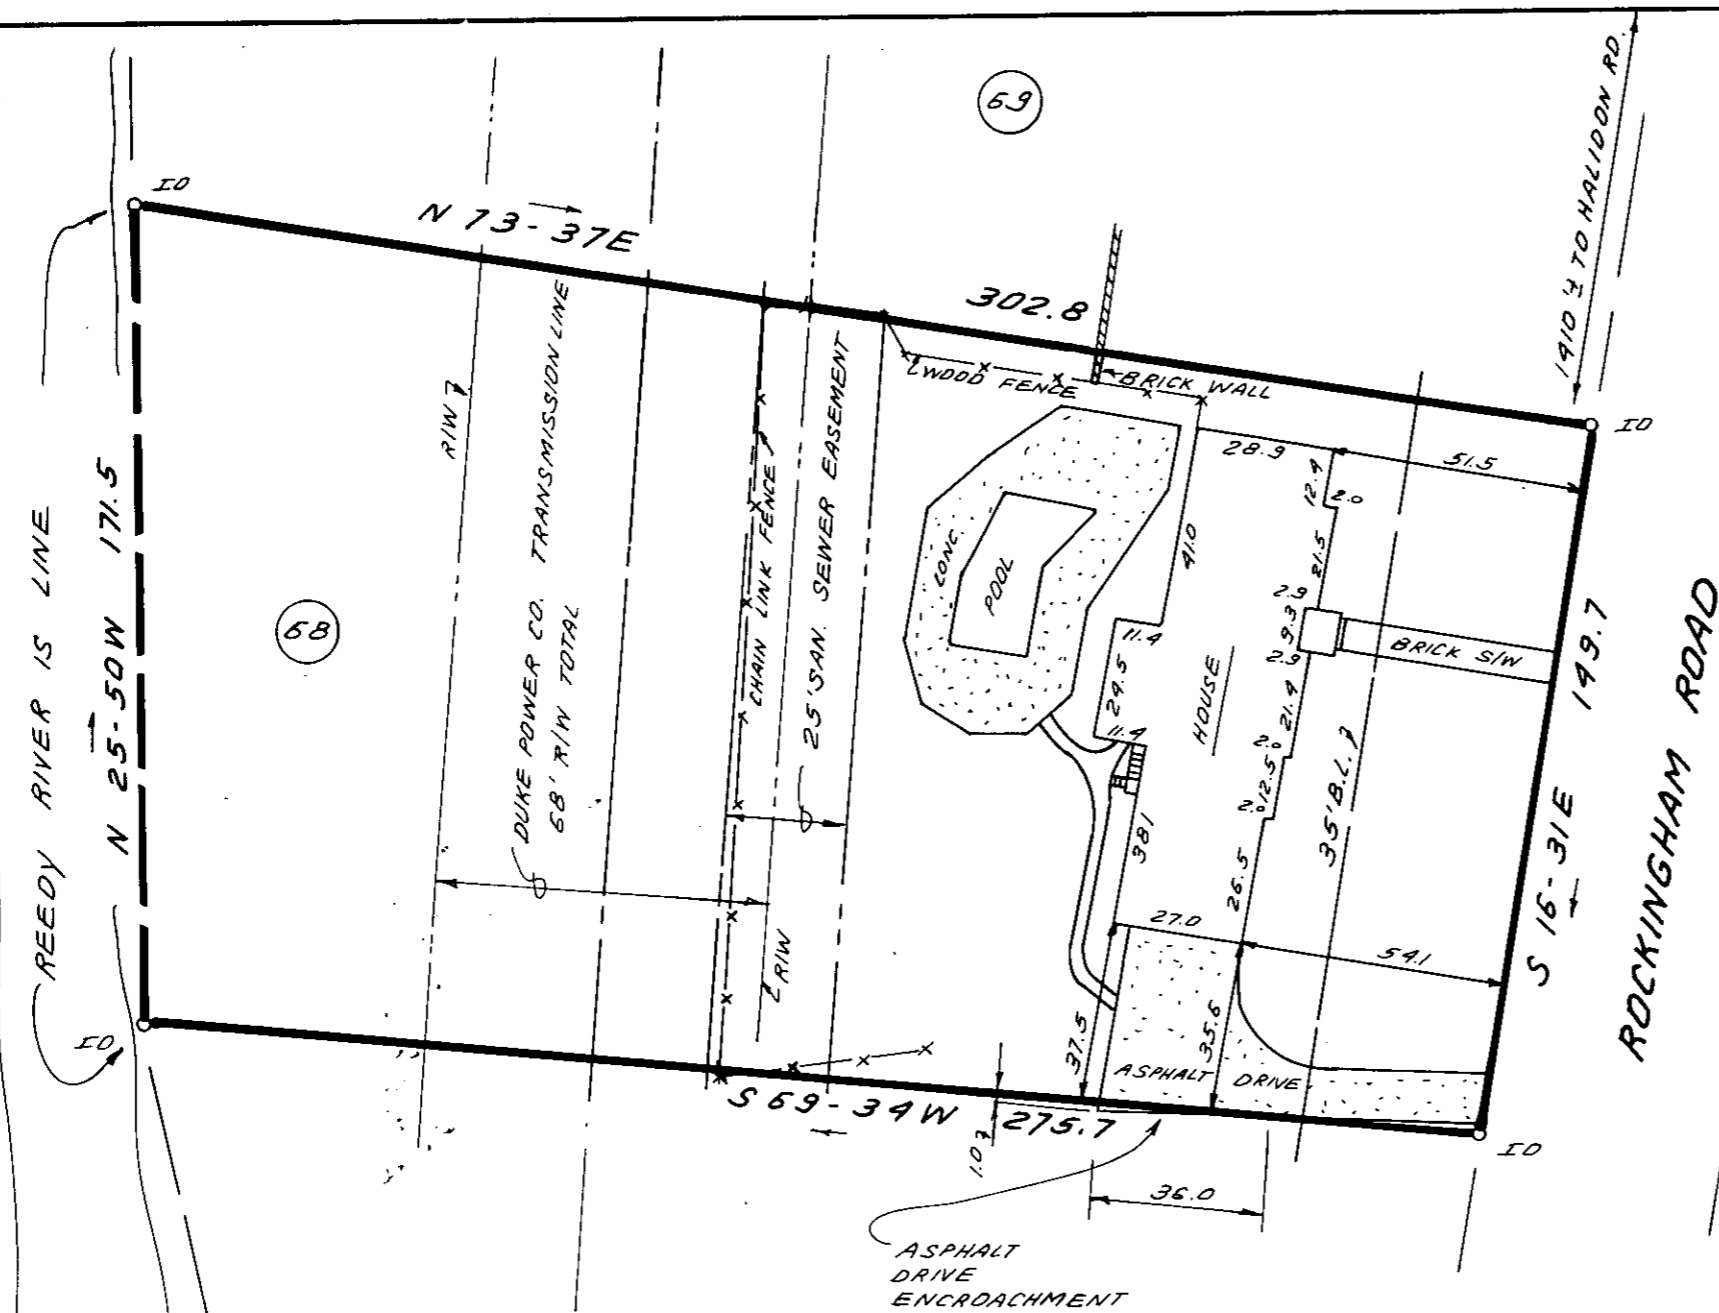

THIS IS TO CERTIFY THAT THE PROPERTY SHOWN ON THIS PLAT WAS SURVEYED UNDER MY DIRECT SUPERVISION. PROPERTY LINES AND IMPROVEMENTS SHOWN ARE LOCATED CORRECTLY AND THAT NO VISIBLE ENCROACHMENTS EXIST UNLESS OTHERWISE SHOWN. THIS HOUSE IS NOT LOCATED IN A DESIGNATED FLOOD HAZARD AREA.

3152 ✓

12-2-16
 JUL 22 1986

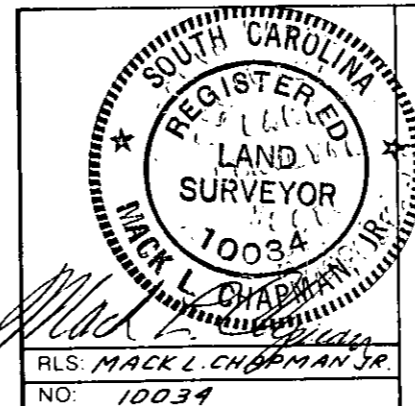

STATE OF SOUTH CAROLINA
GREENVILLE COUNTY

BARKSDALE
LOT 68
 PROPERTY OF
JOHN A. MITCHELL
ELIZABETH L. MITCHELL

FREELAND & ASSOCIATES Engineers • Land Surveyors 318 WEST STONE AVENUE. GREENVILLE, S.C. (803) 271-4924	
PLAT BOOK	80 118 - 119
DEED BOOK	1206 - 610
TAX MAP	M 15.4 - 1-73
PARTY CHIEF	GP 5.0000
DRAWN	BR
DATE	6-23-86
DWG. NO.	15590