

MICROFILMED

FILED
GREENVILLE CO. S. C.
JUL 23 9 29 AM '86
JAMES S. TANKERSLEY
S.M.C.

GODREY

S 53-22 W 543.93 TOT

WOODRUFF ROAD
689' TO GODREY RD.




REF. IO @ 30'

LOT 1
2.94 AC.

LOT 2

S 61-46 E 390.26

161.96
N 39-39 W

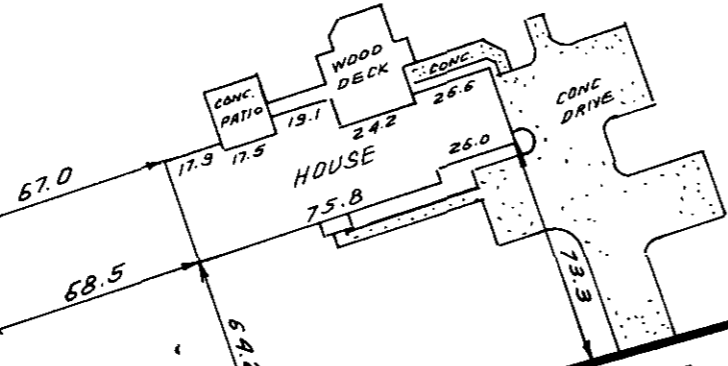

N 26-56 E 431.48 TOT.

REF. IN @ 30'

OAKMEADOW DRIVE



THIS IS TO CERTIFY THAT THE PROPERTY SHOWN ON THIS PLAT WAS SURVEYED UNDER MY DIRECT SUPERVISION. PROPERTY LINES AND IMPROVEMENTS SHOWN ARE LOCATED CORRECTLY AND THAT NO VISIBLE ENCROACHMENTS EXIST UNLESS OTHERWISE SHOWN. THIS PROPERTY IS NOT LOCATED IN A DESIGNATED FLOOD HAZARD AREA.

JUL 23 1986
12-2-18

3334

SOUTH CAROLINA
REGISTERED LAND SURVEYOR
1978
JAMES R. FREELAND

RES. JAMES R. FREELAND
NO. 4781

STATE OF SOUTH CAROLINA
GREENVILLE COUNTY

DAK MEADOWS
LOT 1
PROPERTY OF
JAMES G. TURNER

PATRICIA P. TURNER 86 1134

FREELAND & ASSOCIATES
Engineers • Land Surveyors
318 WEST STONE AVENUE.
GREENVILLE, S.C.
(803) 271-4924

PLAT BOOK	5V-11
DEED BOOK	
TAX MAP	
PARTY CHIEF	RMF
DRAWN	BR
DATE	7-18-86
DWG. NO.	5-001

THE PRINT MACHINE, INC. N61205