MICROFILMED

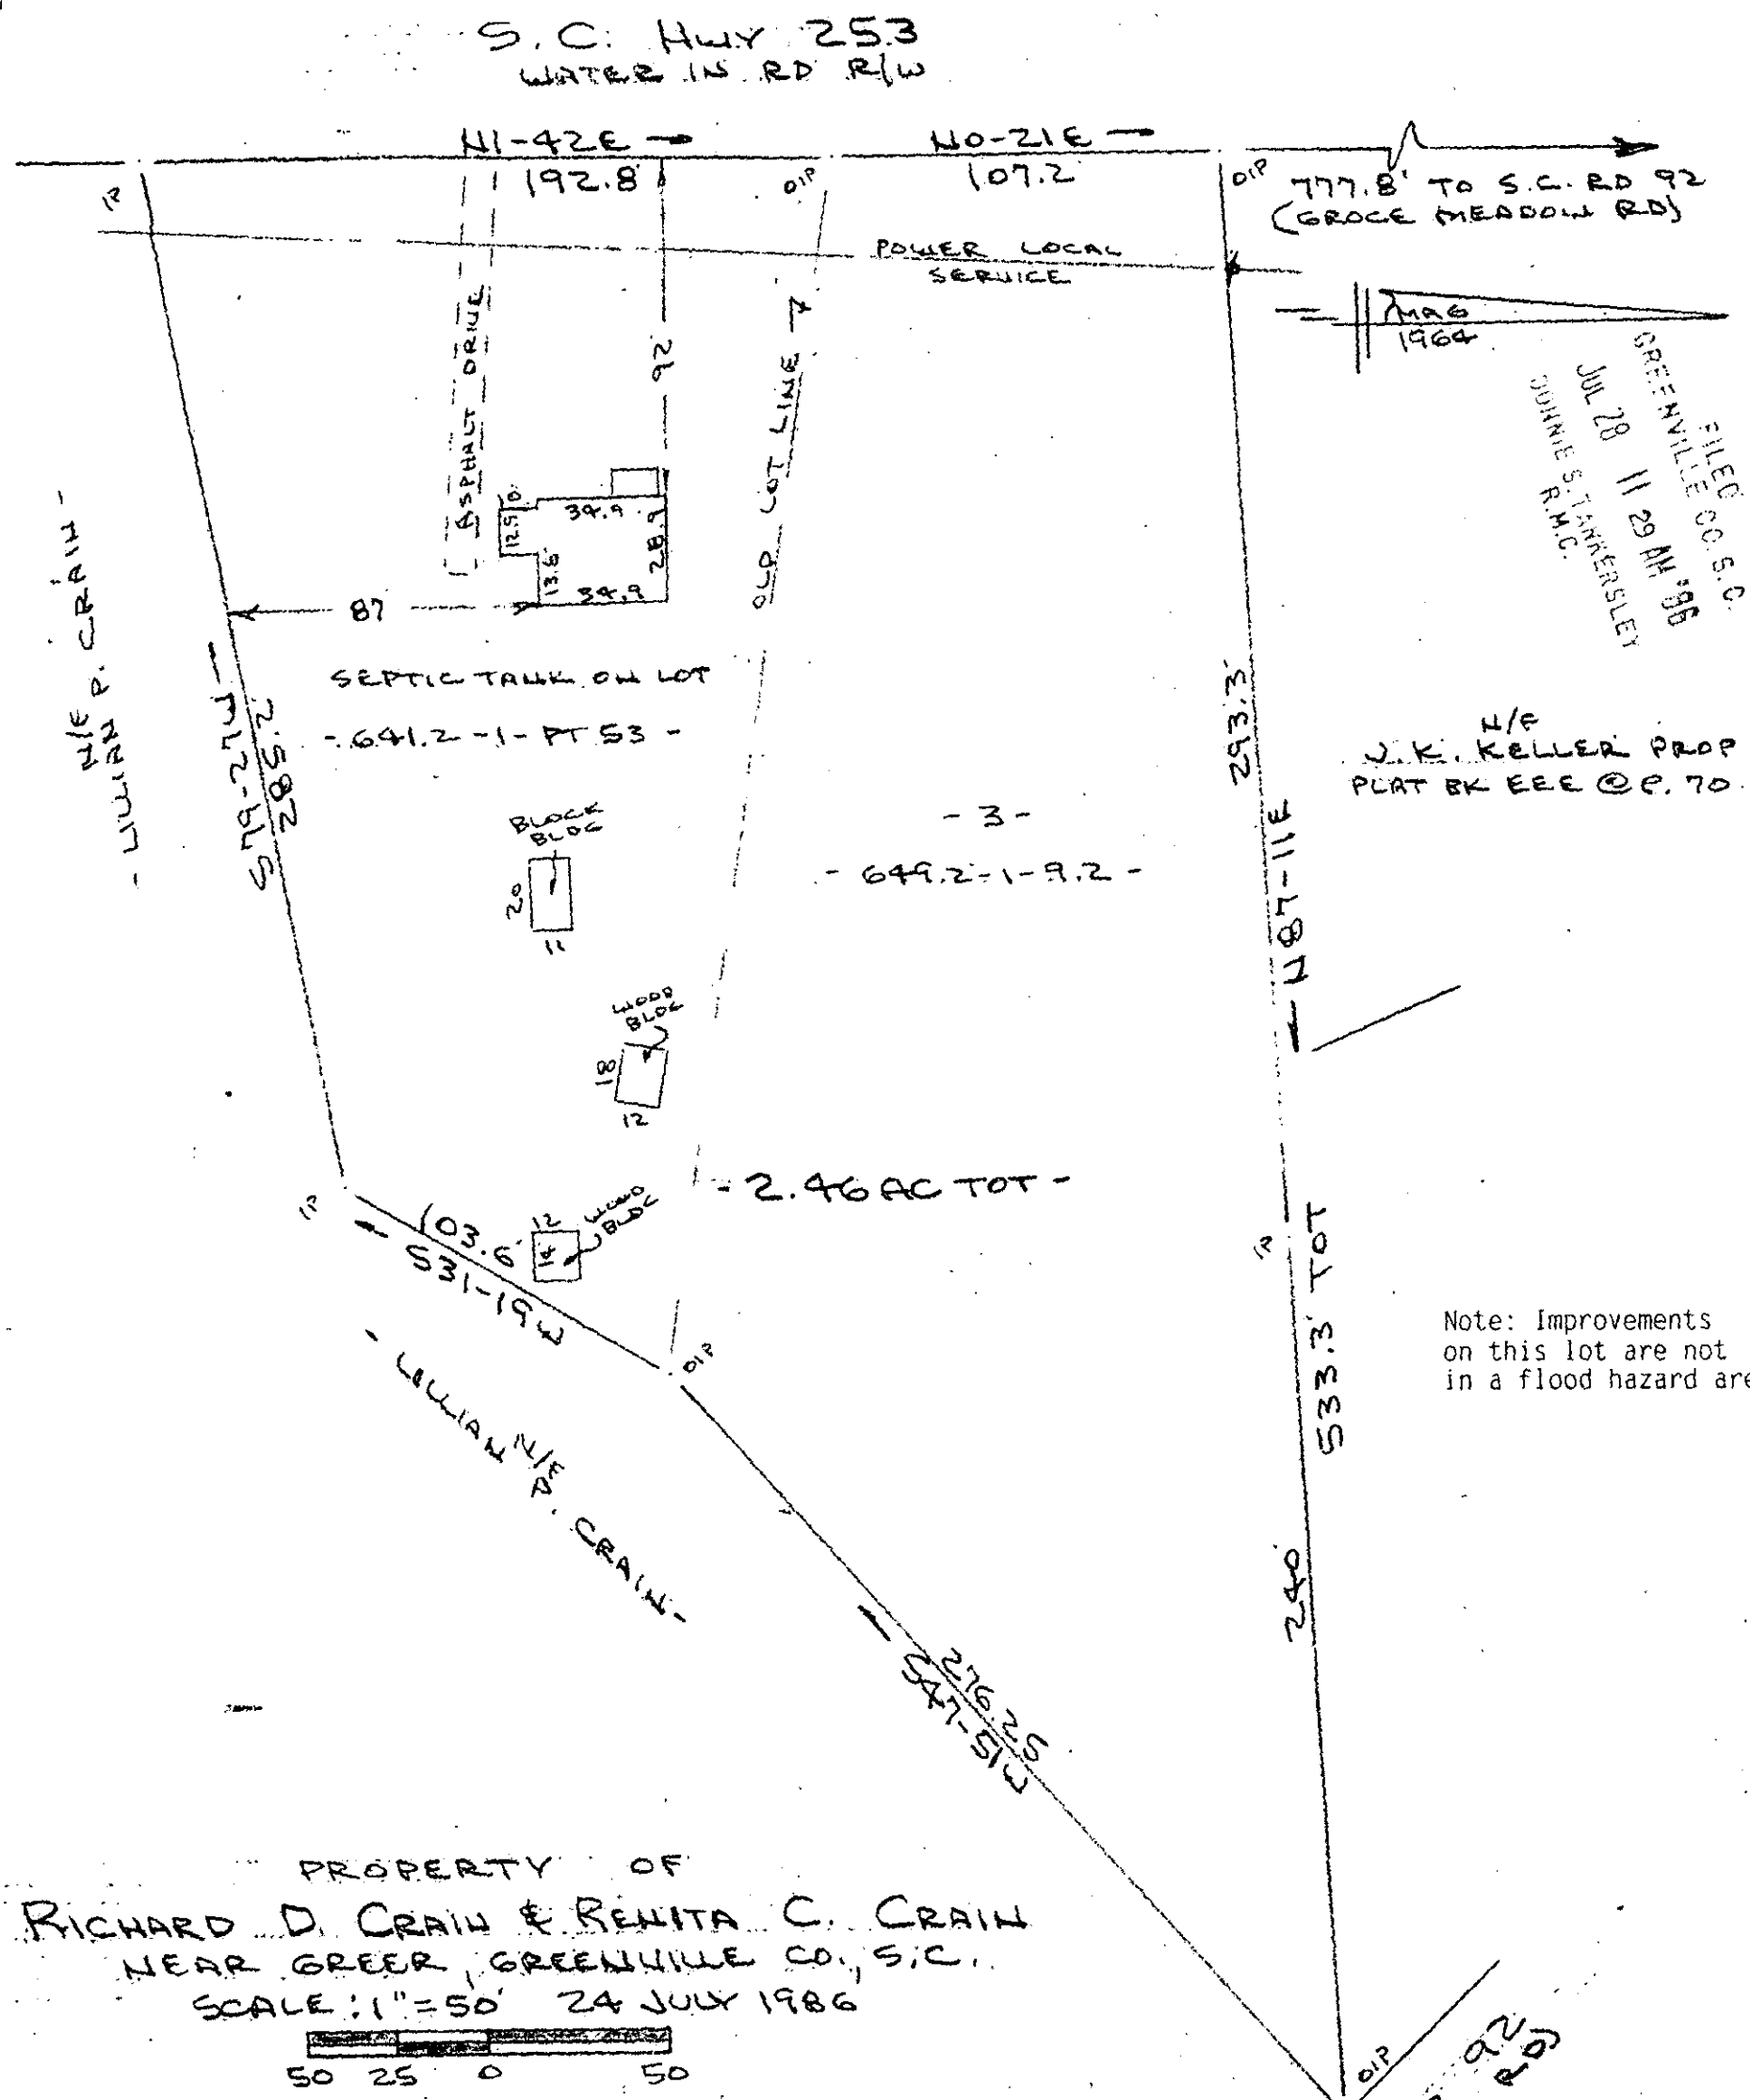

Note: Improvements on this lot are not in a flood hazard area.

FILED
GREENVILLE CO. S.C.
JUL 28 11 29 AM '86
DONNIE S. TANKERSLEY
R.M.C.

PROPERTY OF
RICHARD D. CRAIN & RENITA C. CRAIN
NEAR GREER, GREENVILLE CO., S.C.
SCALE: 1" = 50' 24 JULY 1986

50 25 0 50

This is to certify that on the 24th day of July, 1986, I surveyed the property shown on this plat, being known as 2.46 acres on plat of PROPERTY OF RICHARD D. CRAIN & RENITA C. CRAIN and recorded in the RMC Office Greenville County, S. C., in Plat Book " at Page ; and that the property lines, walls and buildings are as shown hereon, and that the walls and buildings located on said lot do not encroach or project on adjacent street or property, and that no adjacent walls or buildings encroach or project on said premises, no power lines cross this property and no visible encroachments except as shown hereon.

12-Z-30

3888

R. S. Bruce

R. S. Bruce, S.C. RLS # 10288

CAROLINA SURVEYING CO.
112 Manly St.
Greenville, S. C.

Recordable Plat

JUL 28 1986

211/36

641.2-1-PT 53 & 649.2-1-9.2

500 8 5351801