


FILED
 GREENVILLE CO. S.C.
 AUG 12 2 48 PM '86
 DONNIE S. TANKERSLEY
 R.M.C.

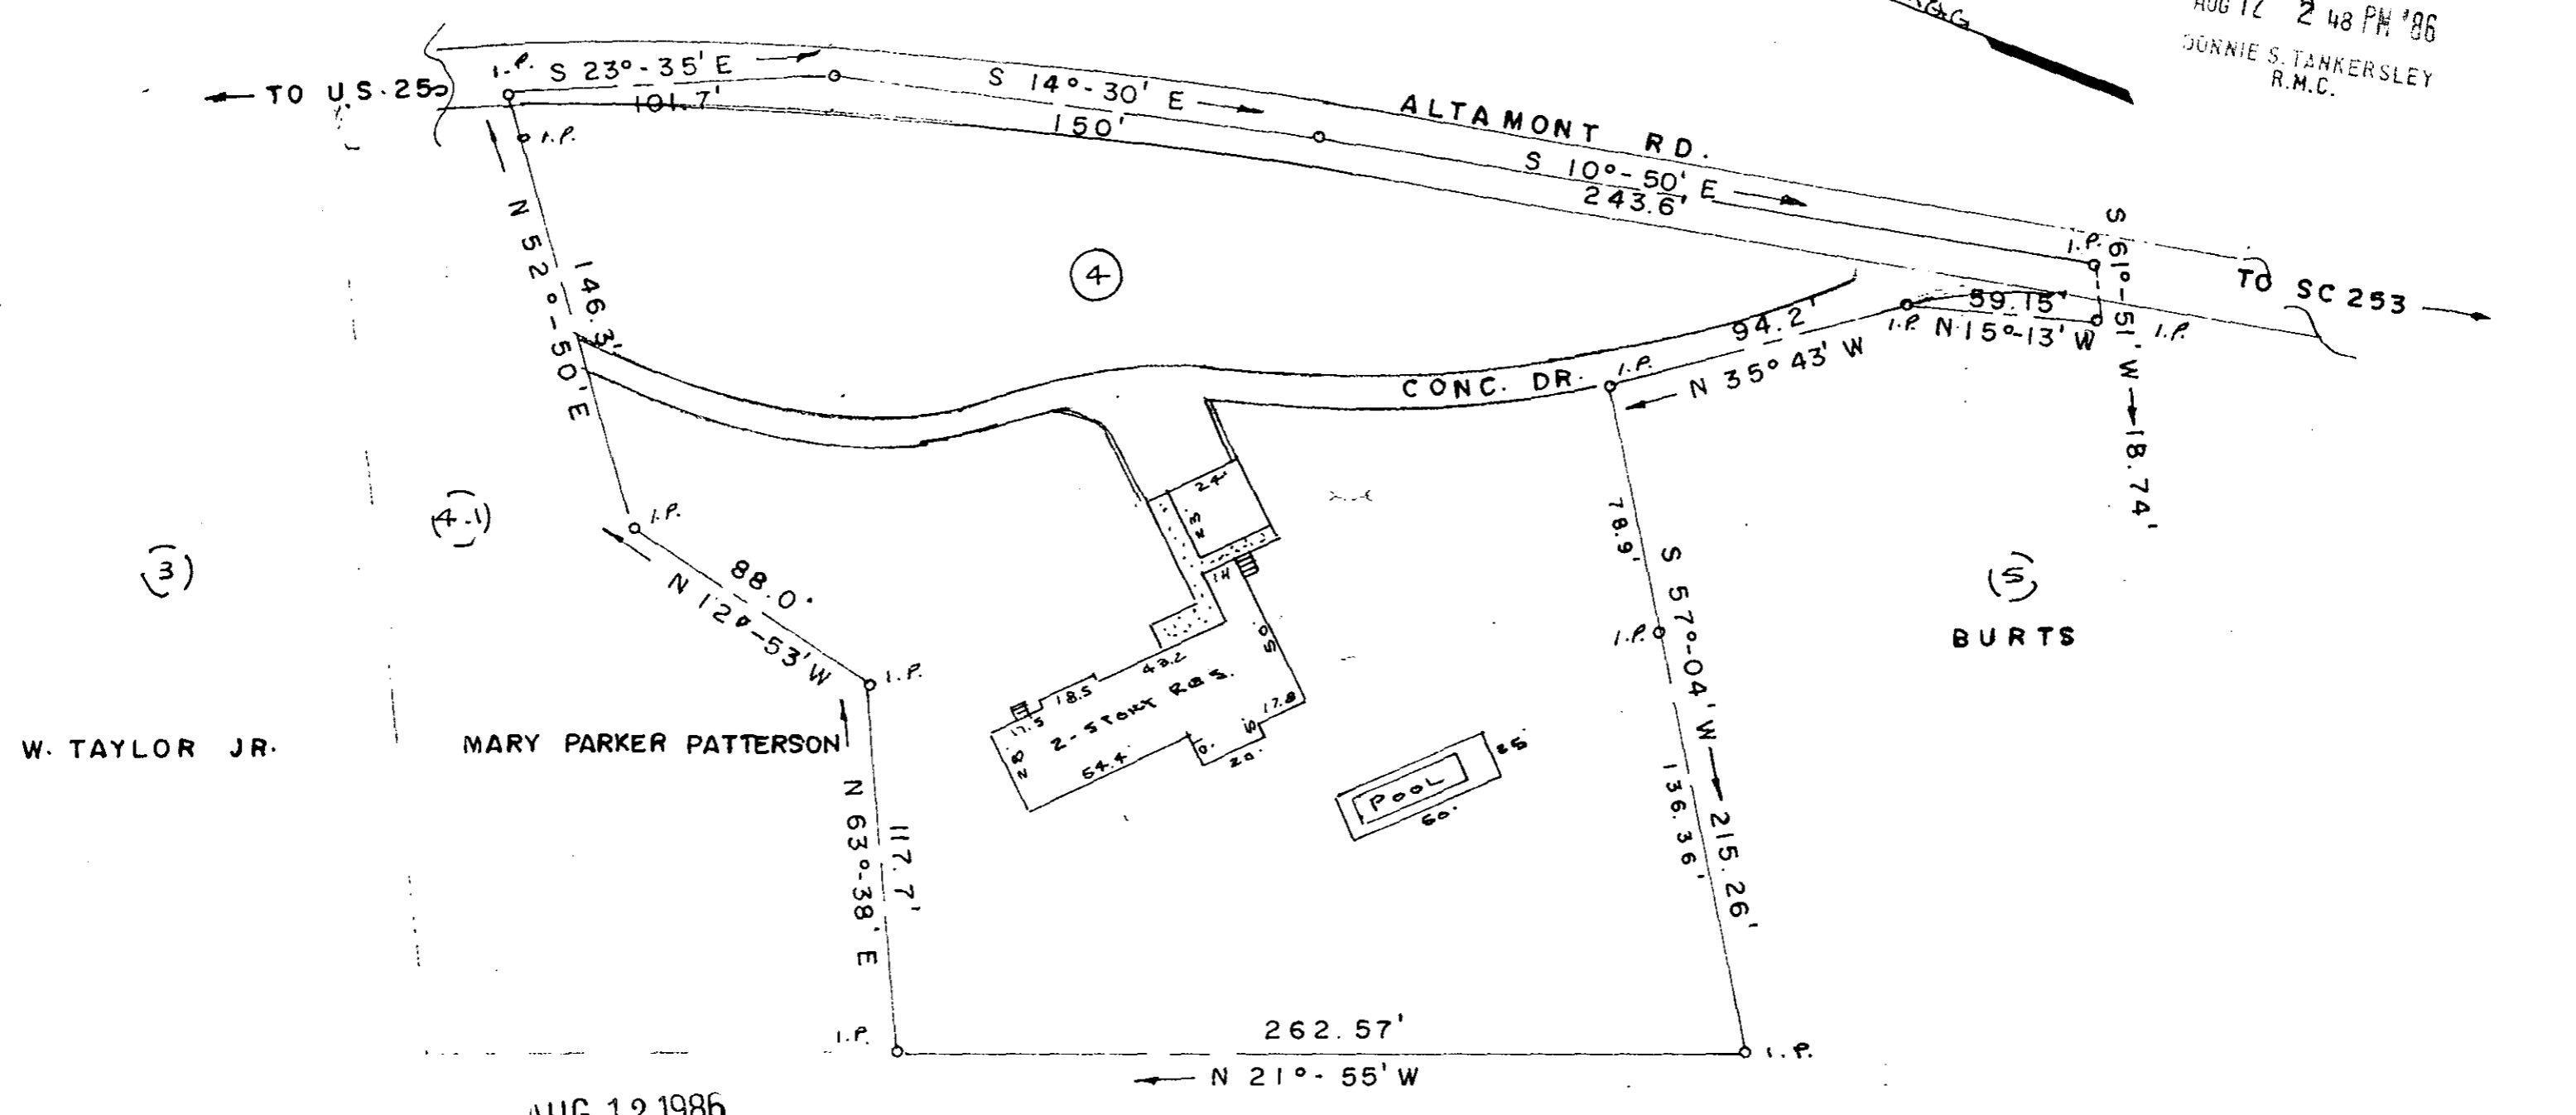


AUG 12 1986

W. TAYLOR JR.

MARY PARKER PATTERSON

W. TAYLOR JR.

BURTS

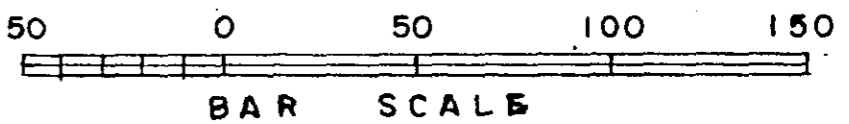

✓ 12-Z-60

REF.
 BLK BK. 461-3-4
 PLT. 6/86 D. & N. CO INC.

6159

I CERTIFY THE ABOVE TRACT HAS BEEN SURVEYED AND IS AS SHOWN TO THE BEST OF MY KNOWLEDGE. NO ENCROACHMENTS AND NOT LOCATED IN A HAZARD FLOOD PLAIN.

Kenneth J. Gould
 S C REG NO. 4035

PROPERTY OF		
Wm. M. & CAROL J. LANDRETH		
SCALE: 1" = 50'	APPROVED BY	DRAWN BY KTG
DATE: 8/9/86		
GREENVILLE CO. PARIS MT. TWP.	2.11± Ac.	GREENVILLE S. CAROLINA
K.T. GOULD, INC. LAND SURVEYING TAYLORS, SC		DRAWING NUMBER

MICROFILMED