


STRINGER 25

GRIFFIN 25A

Note:
 This is Lot # 20
 North Hills, Plat
 Book H - Page 91.

FILED
 GREENVILLE CO. S. C.
 AUG 14 12 16 PM '86
 JENNIE S. TANKERSLEY
 R.M.C.

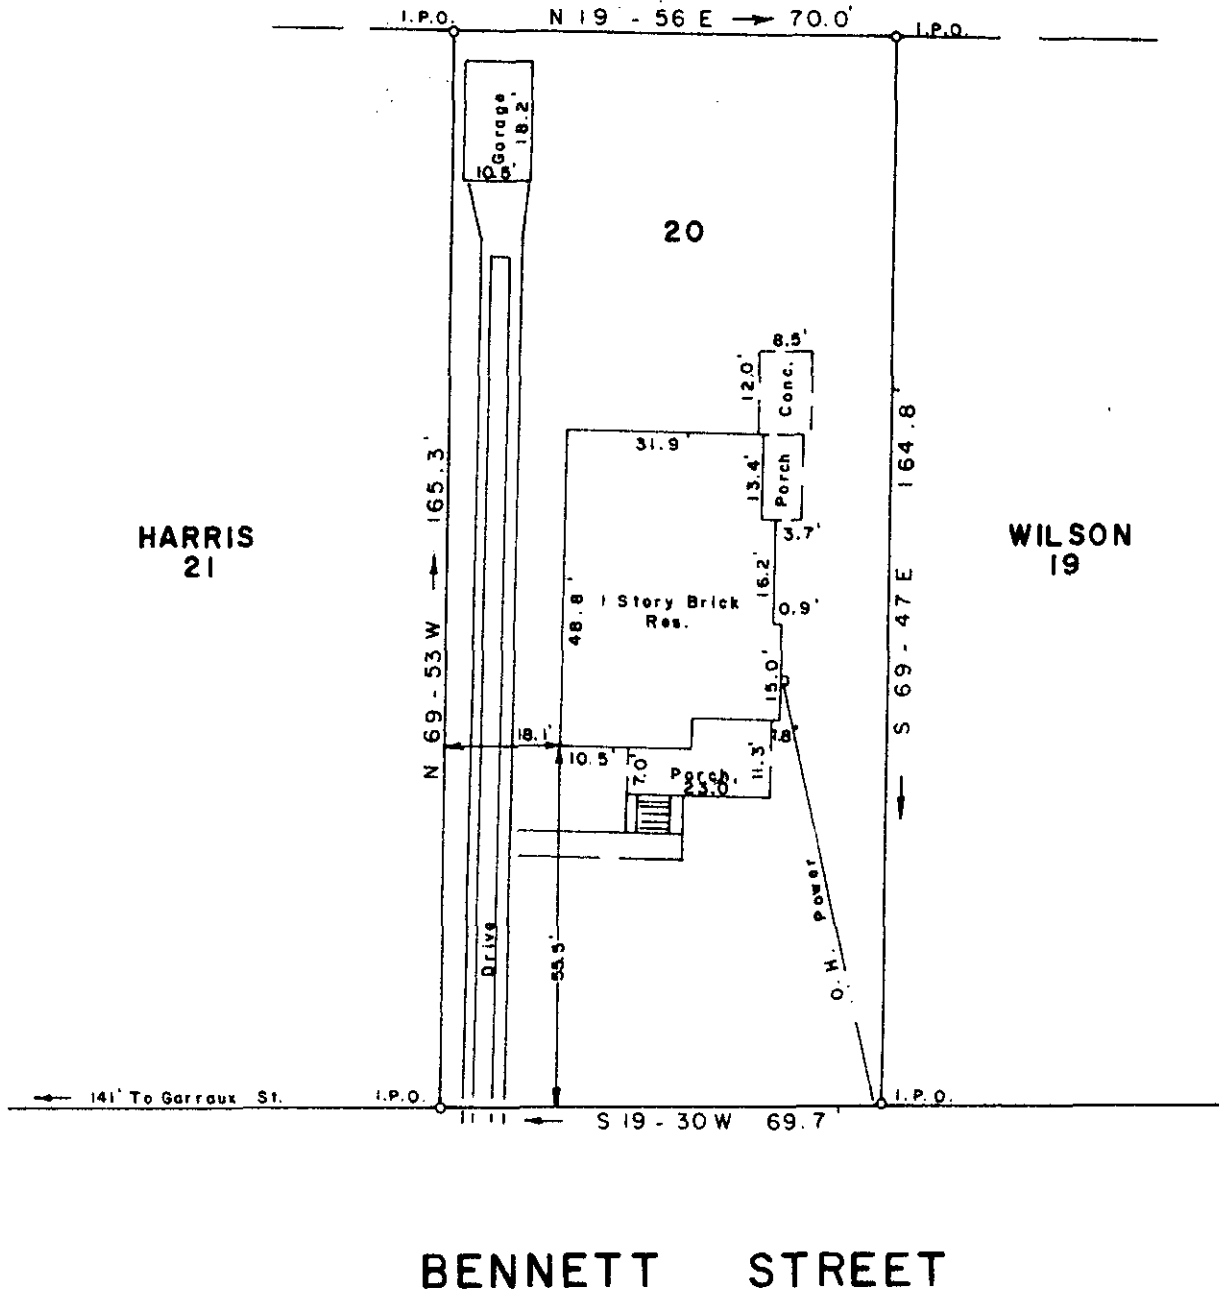

SURVEY FOR
MARK A. STONE
SARA K. SHARP
 CITY OF GREENVILLE GREENVILLE COUNTY
 SOUTH CAROLINA
 AUGUST 7, 1986

6509 ✓

12-2-68


To The Best Of My Knowledge This Structure
 Is Not In An Established Flood Zone.

I Hereby Certify That The Measurements As
 Shown Above Are Correct And There Are No
 Encroachments Or Projections Other Than
 Shown.

AUG 14 1986

I Hereby Certify That The Ratio Of Precision
 Of The Field Survey Is 1/5000 As Shown
 Hereon And The Area Was Determined By Computer.

JEFFERY M. PLUMBLEE, INC.
 LAND SURVEYING

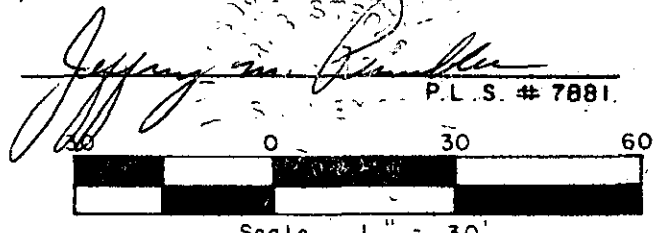

P. O. BOX 788
 TRAVELERS REST, S. C. 29690

(803) 834-4426

F. B. 41

35 - 1 - 38

500 3 14381A01