


Plat Book B, Page 5

Recorded in Plat Book B, Page 5

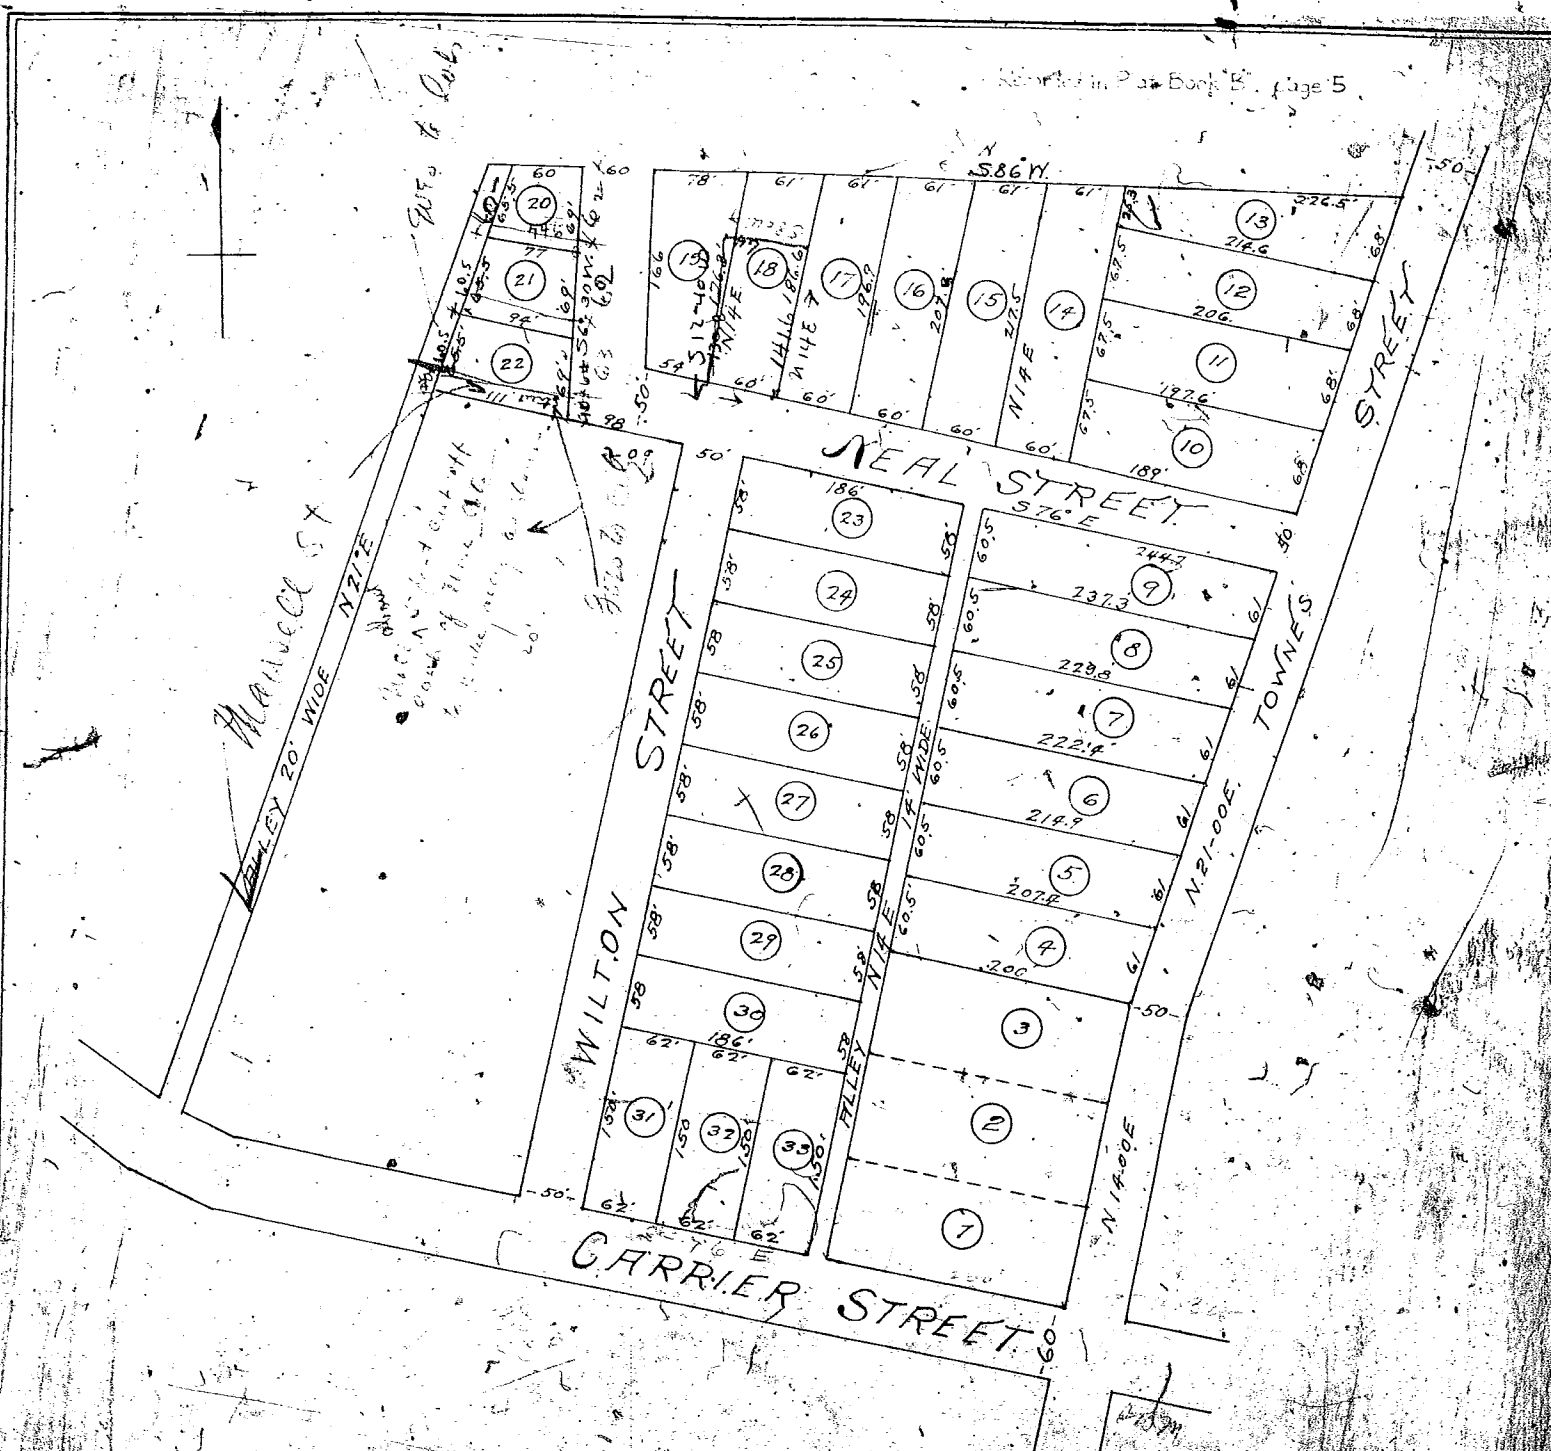

PLAN OF TOWNES STREET PROPERTY
 BELONGING TO

W. C. CLEVELAND.

CLEVELAND & WILLIAMS, AGTS.

GREENVILLE S. C.

Approved Oct 23 1909
 Harry J. ...
 Clerk

Scale 100 Feet = 1" / October 1909

