
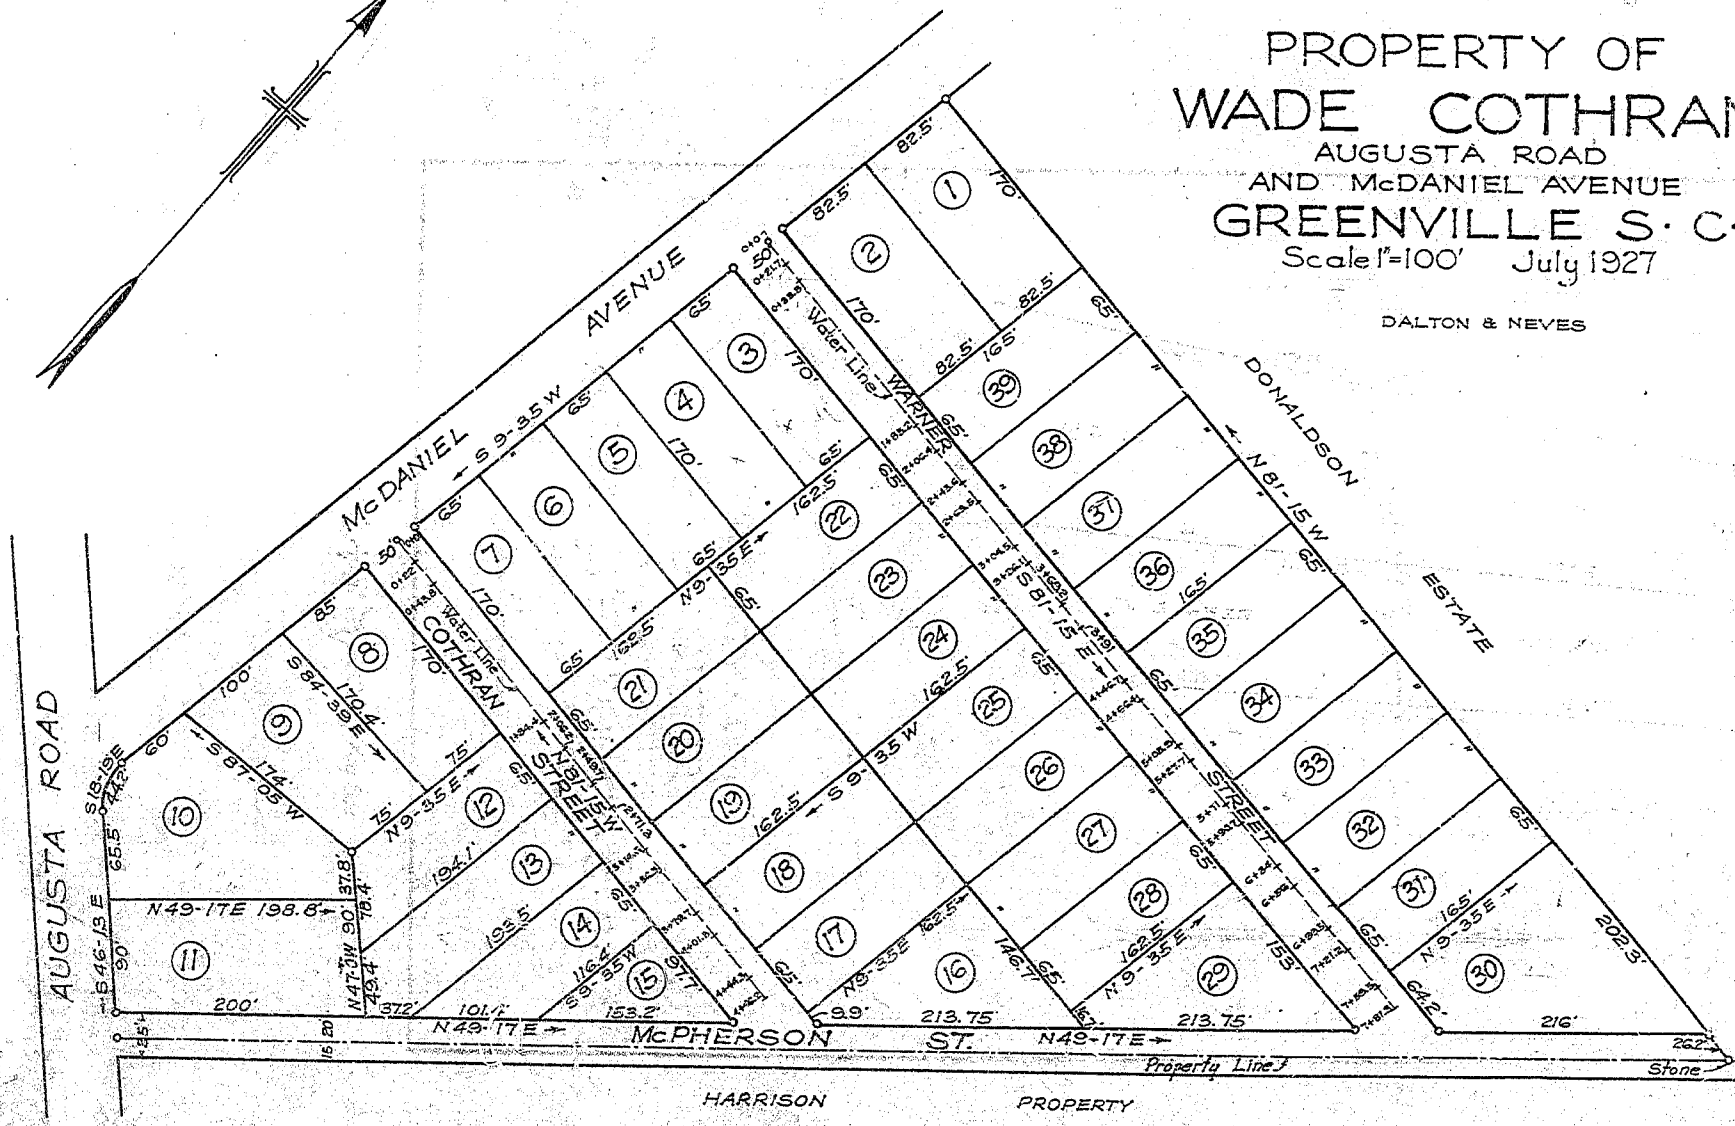


PROPERTY OF  
**WADE COTHRAN**  
 AUGUSTA ROAD  
 AND McDANIEL AVENUE  
**GREENVILLE S. C.**  
 Scale 1"=100' July 1927

DALTON & NEVES

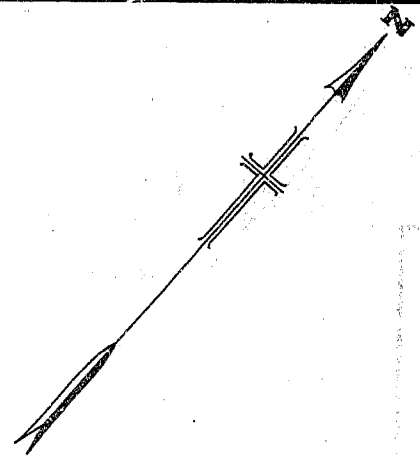

Iron Pipe at all Lot Corners

F. Book No. 112  
 JOB NO. 1371-1

**BAD COPY**

Recorded March 26, 1930, by Kay Bee

163