Plat Book I, Page 11

MAP OF
PART OF TRACT NO. 8 OF
F·W·POE · MFG · CO · LAND
GREENVILLE COUNTY · S·C·
AS SHOWN ON
LOCKWOOD · GREENE CO. MAP DATED 1910
Scale 1"=50' Sept. 1928
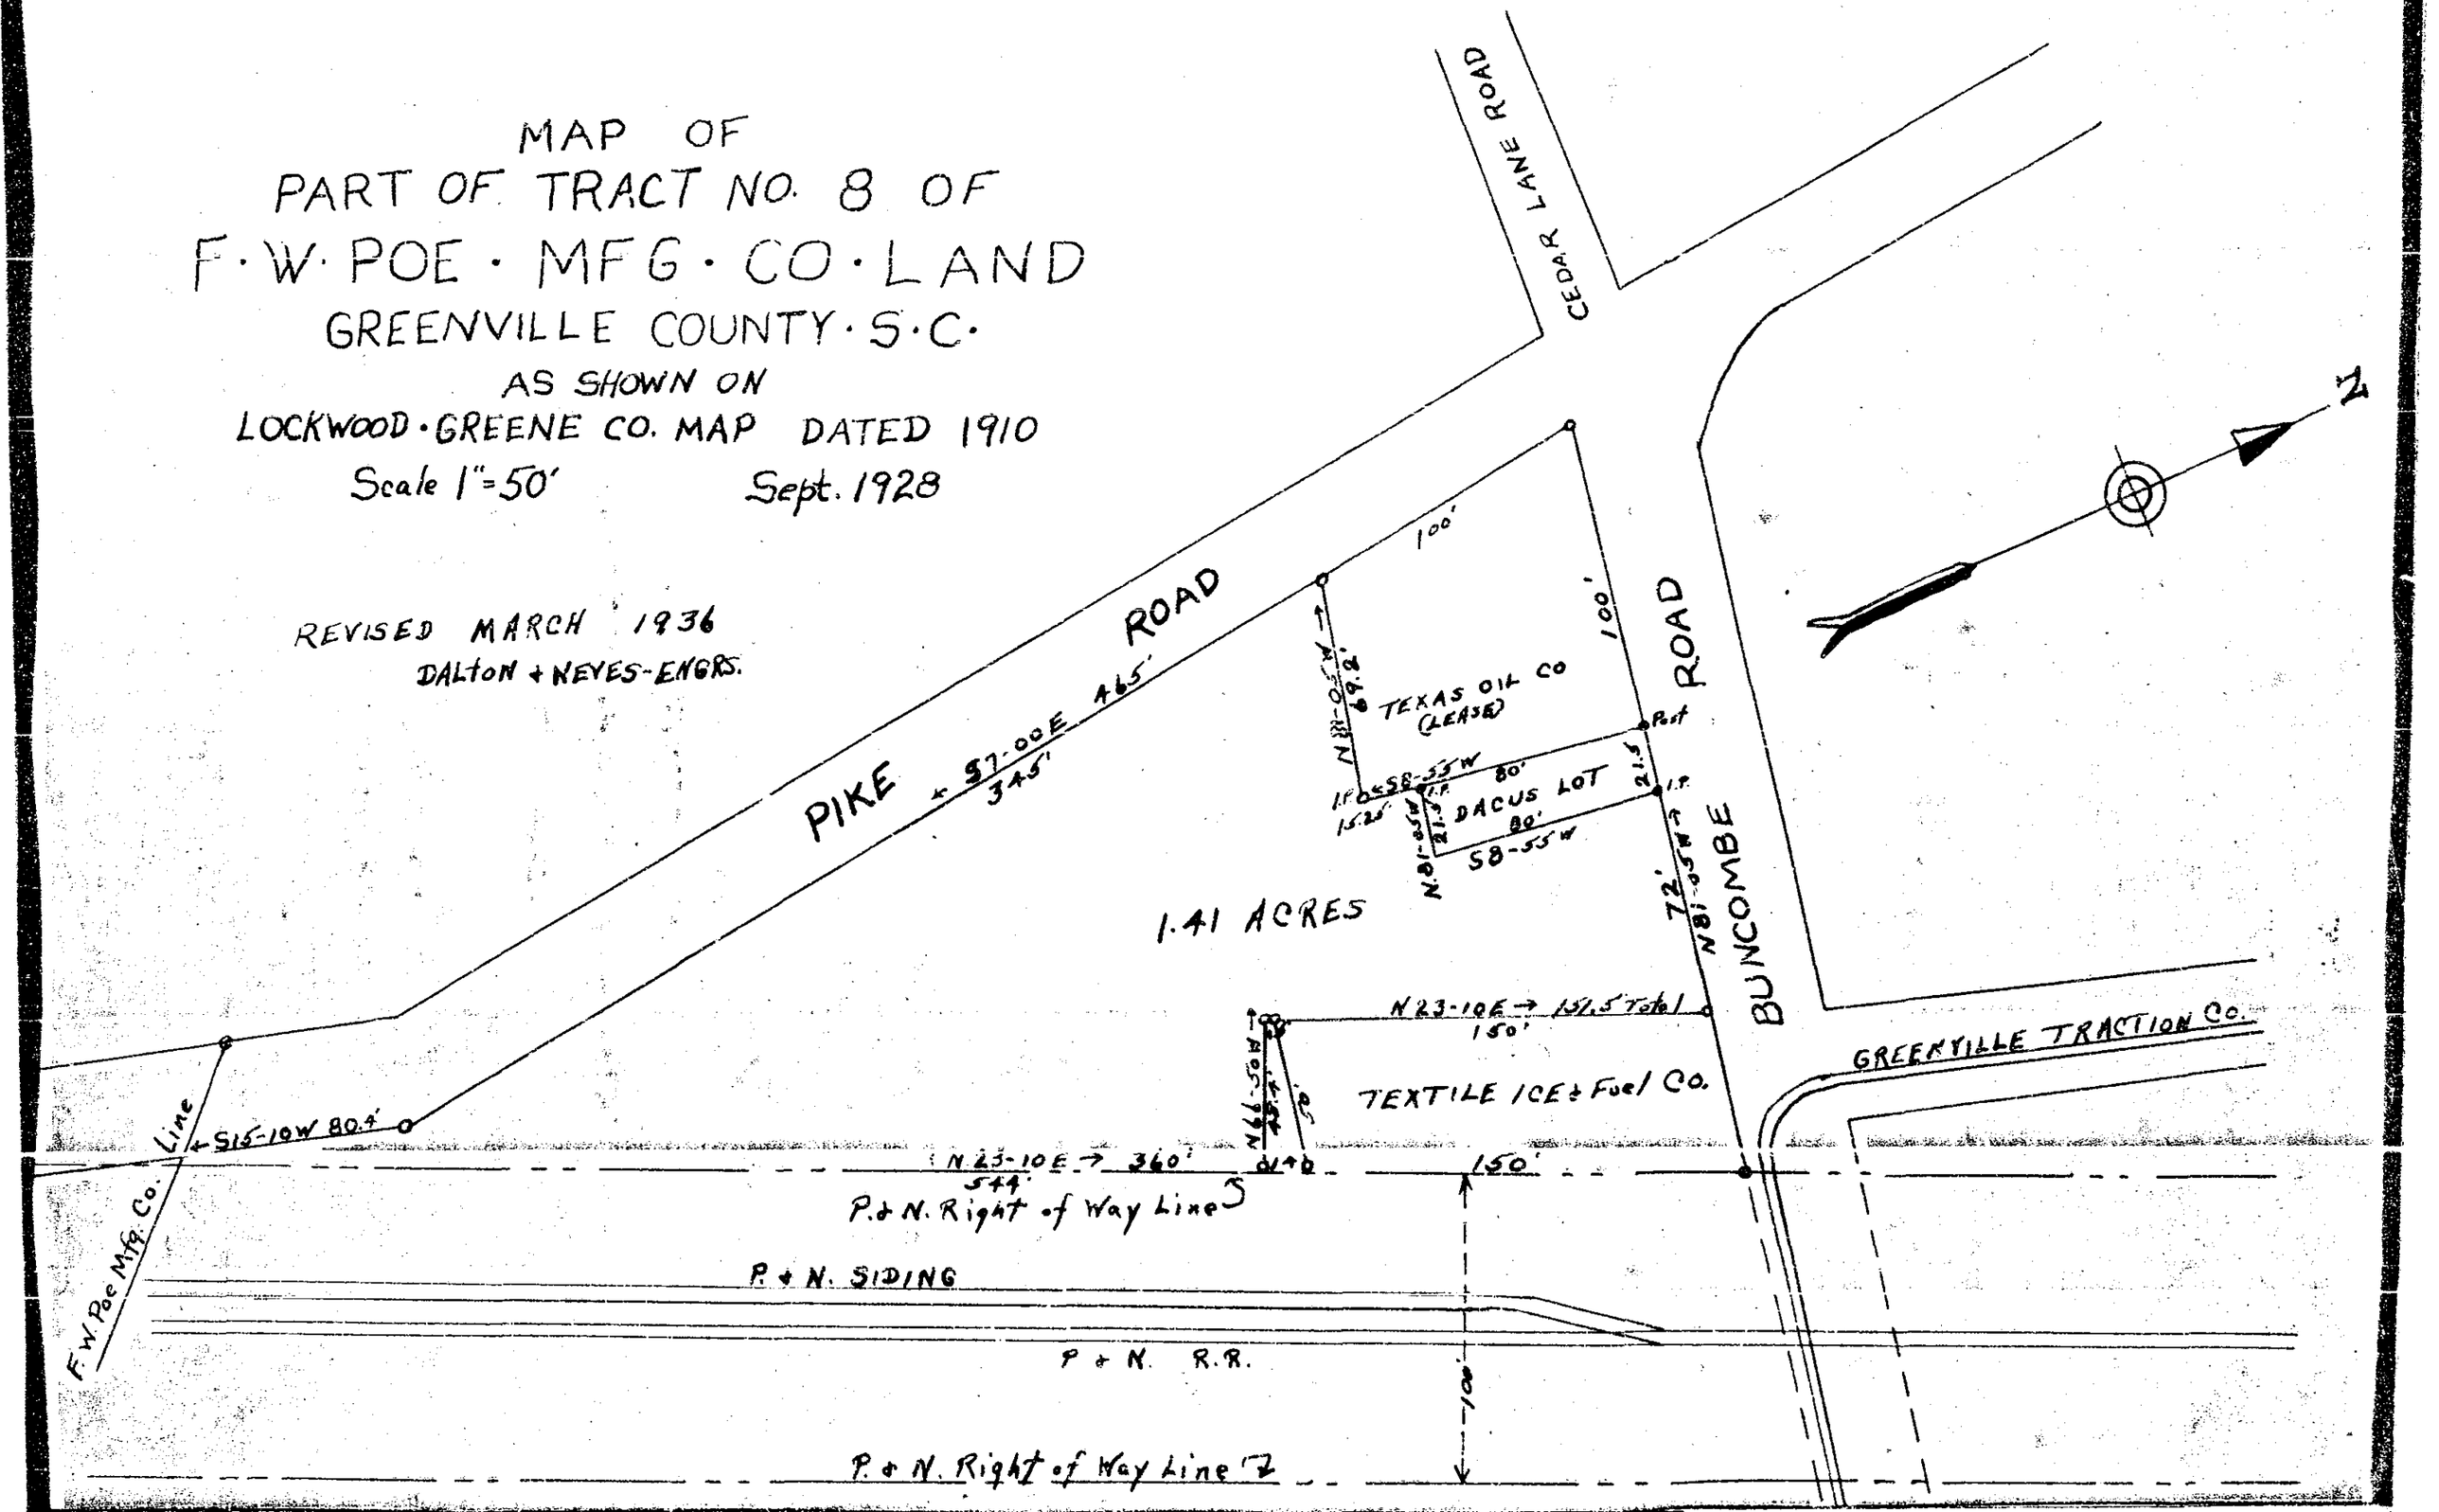
REVISED MARCH 1936
DALTON + NEVES-ENGRS.