


W SHELL THACKSTON

REF: PLAT OF W. SHELL THACKSTON
LAND, MADE BY W.P. MORROW
IN JUNE 1952 (UNRECORDED)

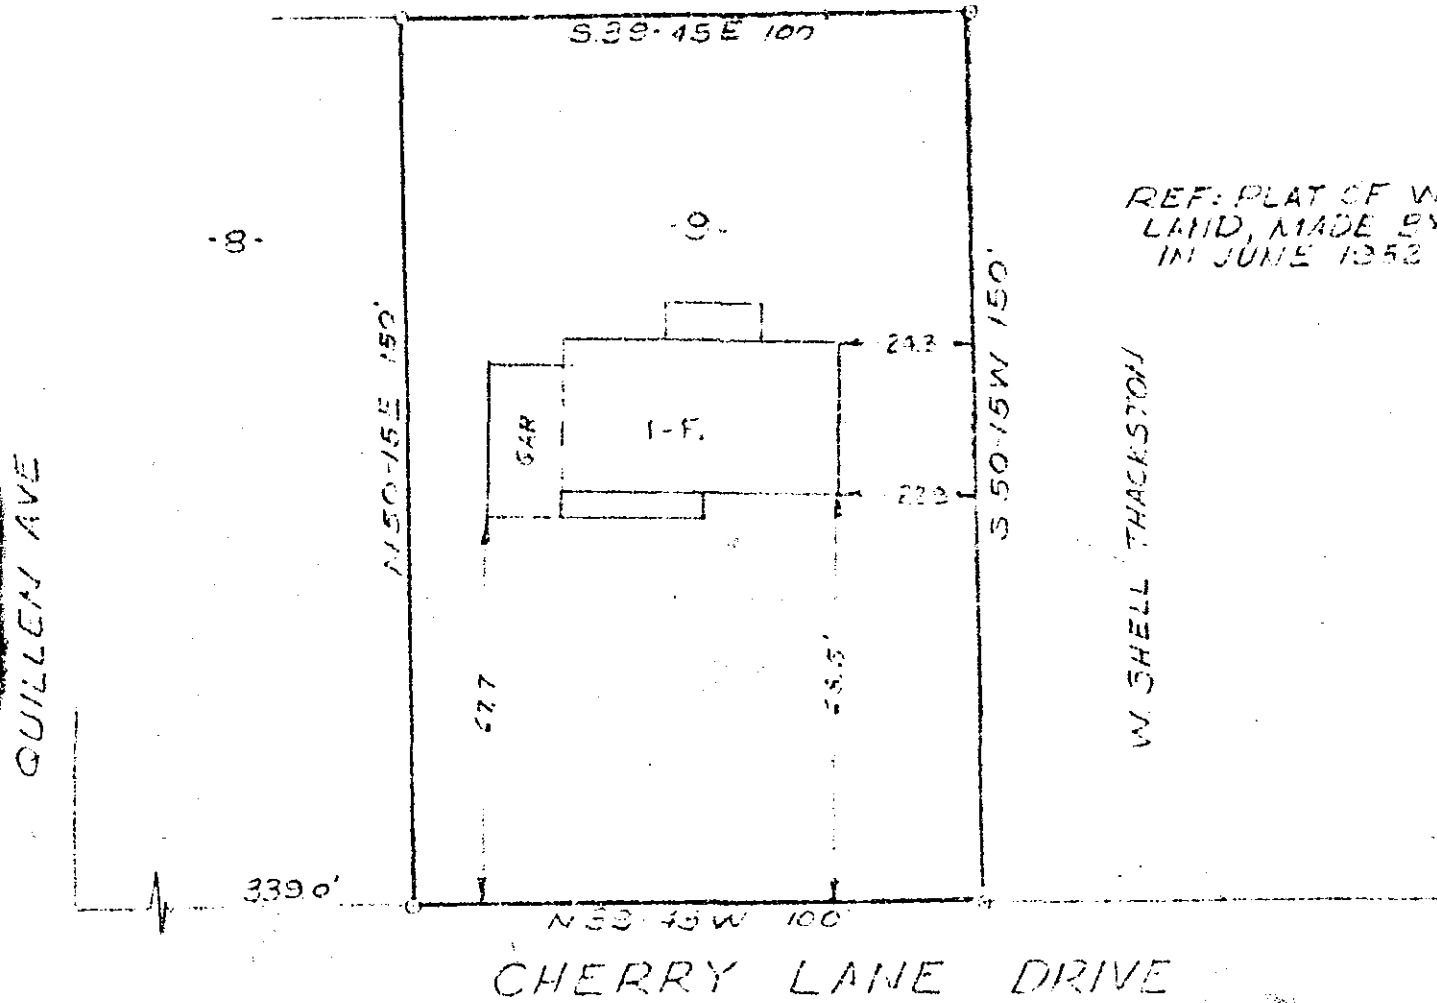

PROPERTY OF
ETHEL R. CASEY
FOUNTAIN INN S.C.

SCALE: 1" = 40 FT. OCT 20, 1953

This is to certify that on the 20th day of October, 1953, I surveyed the property shown on this plat; and that the property lines, wall and buildings are as shown hereon; that the buildings located on said lot do not encroach or project on adjacent streets or property; and that no adjacent buildings or walls encroach or project on said property.

[Handwritten Signature]
Reg. Engineer # 808



FIEDMONT ENGINEERING SERVICE
GREENVILLE, S. C.

B 105

DD/44

#23678-702 This 29 day of OCT 19 53
And Recorded in Vol DD Page 44
[Handwritten Signature]
Register of Deeds Greenville County, S. C.