


# Plat Book-II-Page 17A

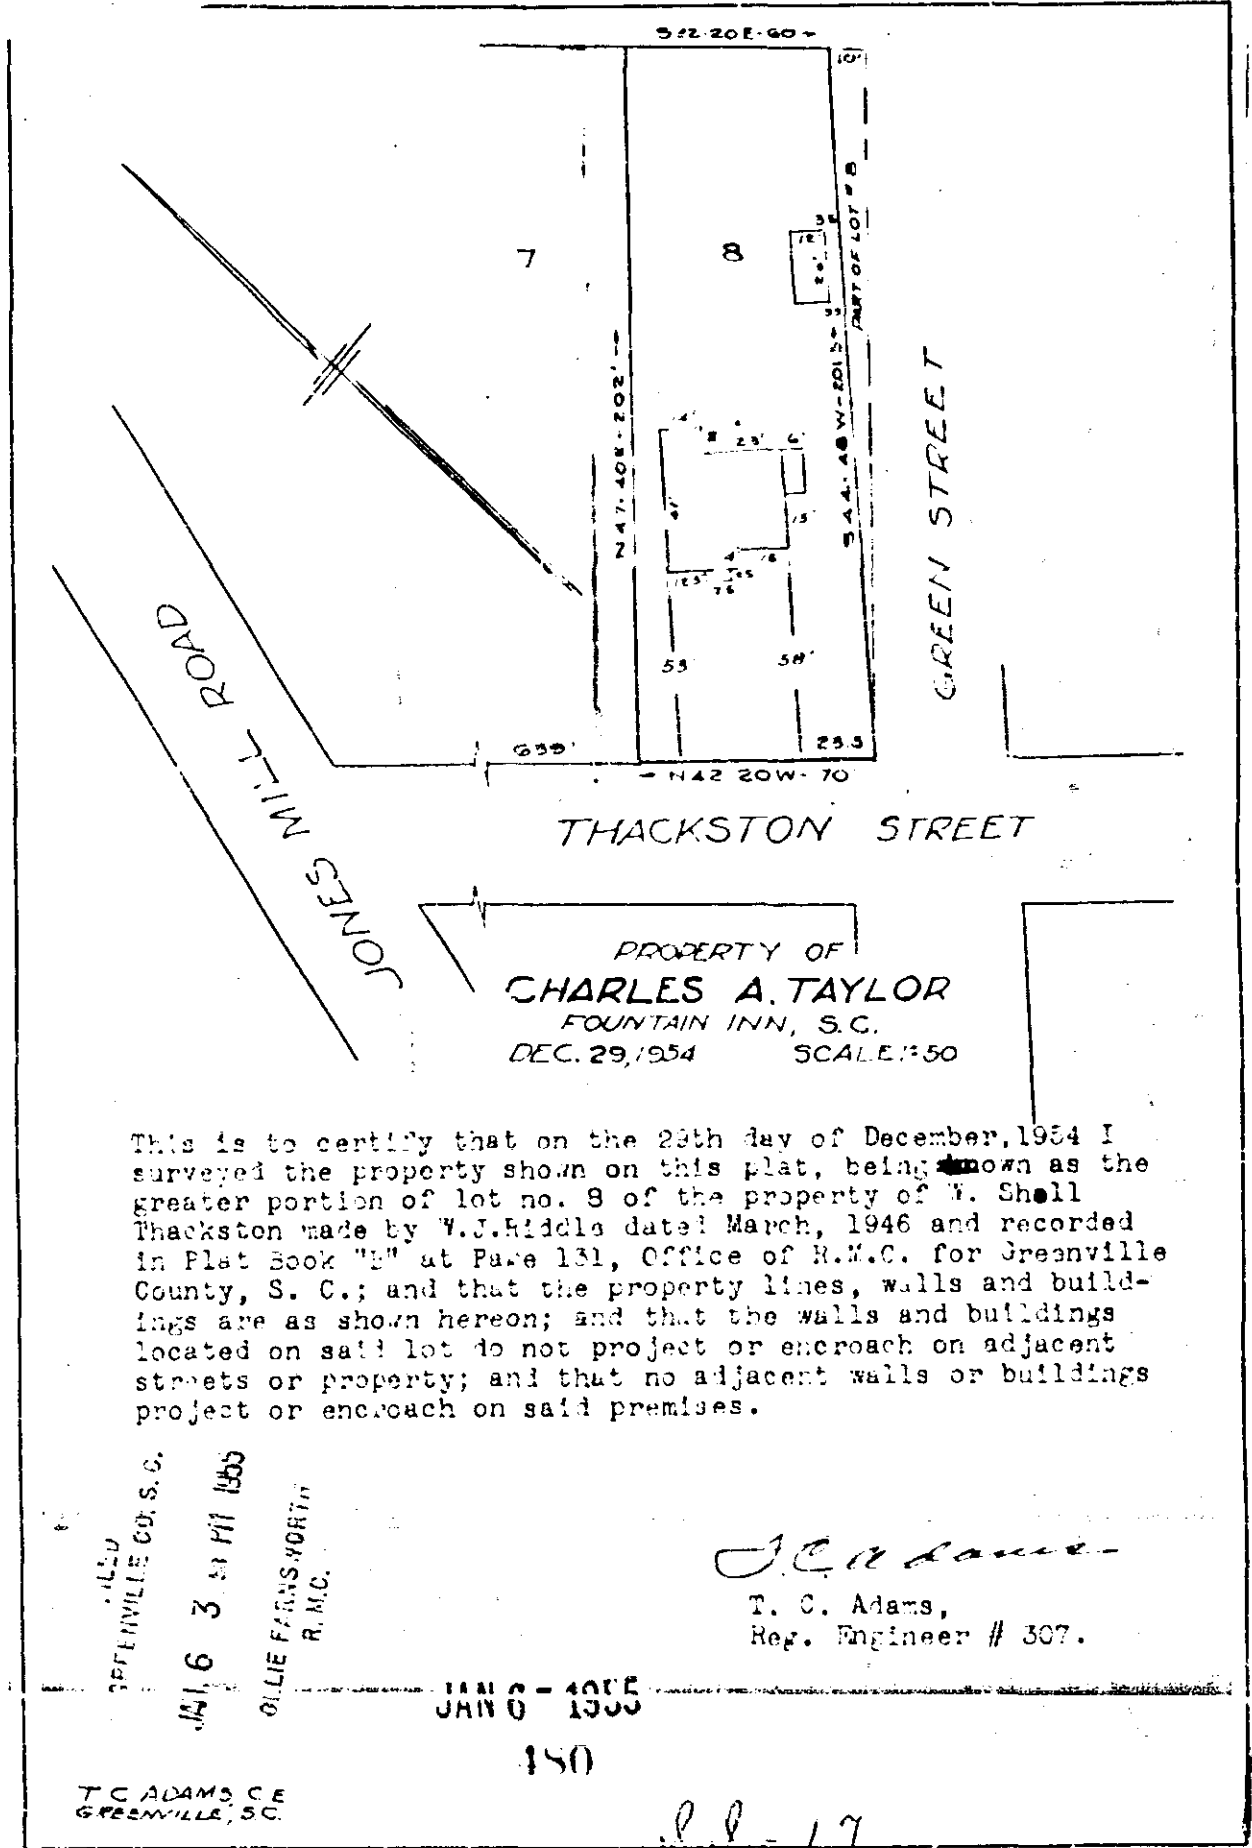

This is to certify that on the 29th day of December, 1954 I surveyed the property shown on this plat, being known as the greater portion of lot no. 8 of the property of W. Shell Thackston made by W. J. Riddle dated March, 1946 and recorded in Plat Book "B" at Page 131, Office of R. M. C. for Greenville County, S. C.; and that the property lines, walls and buildings are as shown hereon; and that the walls and buildings located on said lot do not project or encroach on adjacent streets or property; and that no adjacent walls or buildings project or encroach on said premises.

*T. C. Adams*  
 T. C. Adams,  
 Reg. Engineer # 307.

JAN 6 - 1955  

T. C. ADAMS, C.E.  
 GREENVILLE, S.C.

# 480 Filed This 6 day of Jan. 19 55  
 And Recorded in P. B. Page 17 A  
*Ollie Farnsworth*  
