


# Plat Book-II-Page 65 A

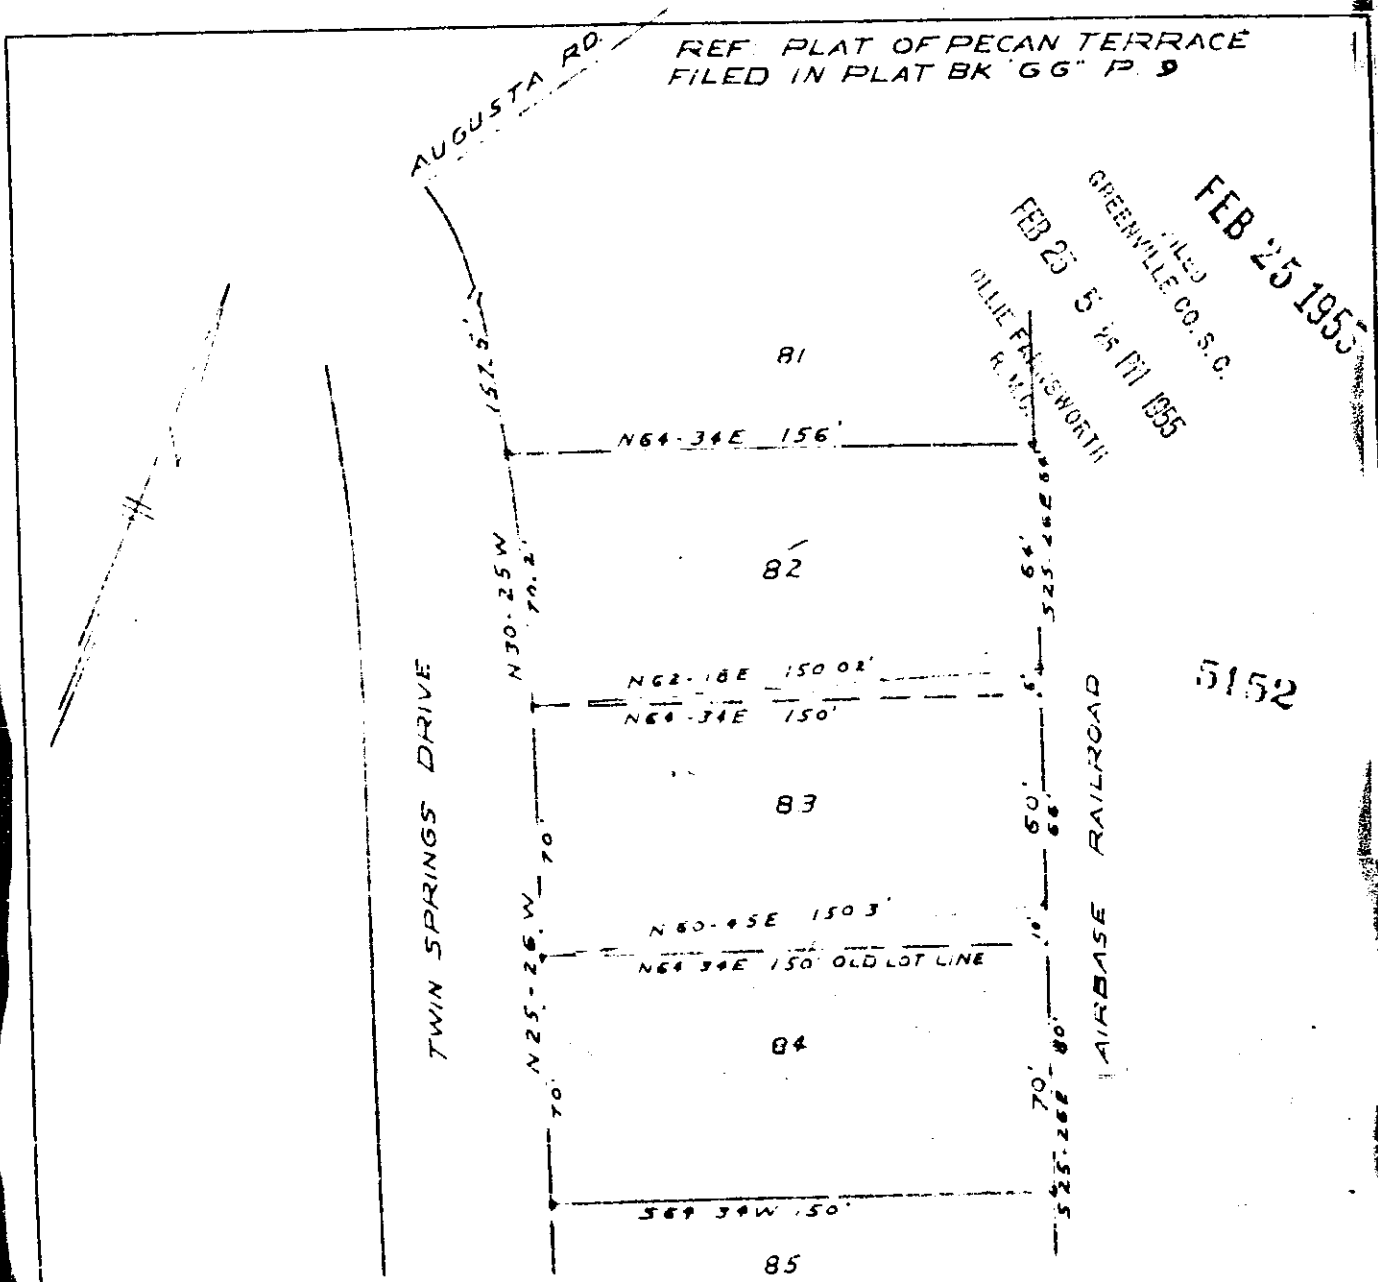

REVISION OF LOTS 82 83 AND 84  
 PECAN TERRACE  
 SCALE 1" = 50 FT 25 FEB 1955  
 NEAR GREENVILLE S. C.

*Revision of sides (as indicated)  
 Lot lines - Lots 82, 83 & 84  
 on Twin Springs Drive  
 approved 2/25/55*

*J. H. Crouton  
 City Engr.*  
 PIEDMONT ENGINEERING SERVICE  
 GREENVILLE S. C.



*500  
 88-65*

#9197 Filed This 25 day of Feb 1955  
 and Recorded in P. E. P. 65 of ...  
*Willie Fawcett*  
 Register of Deeds Greenville County, S. C.