


200
299
90
86
375
100
1144

183

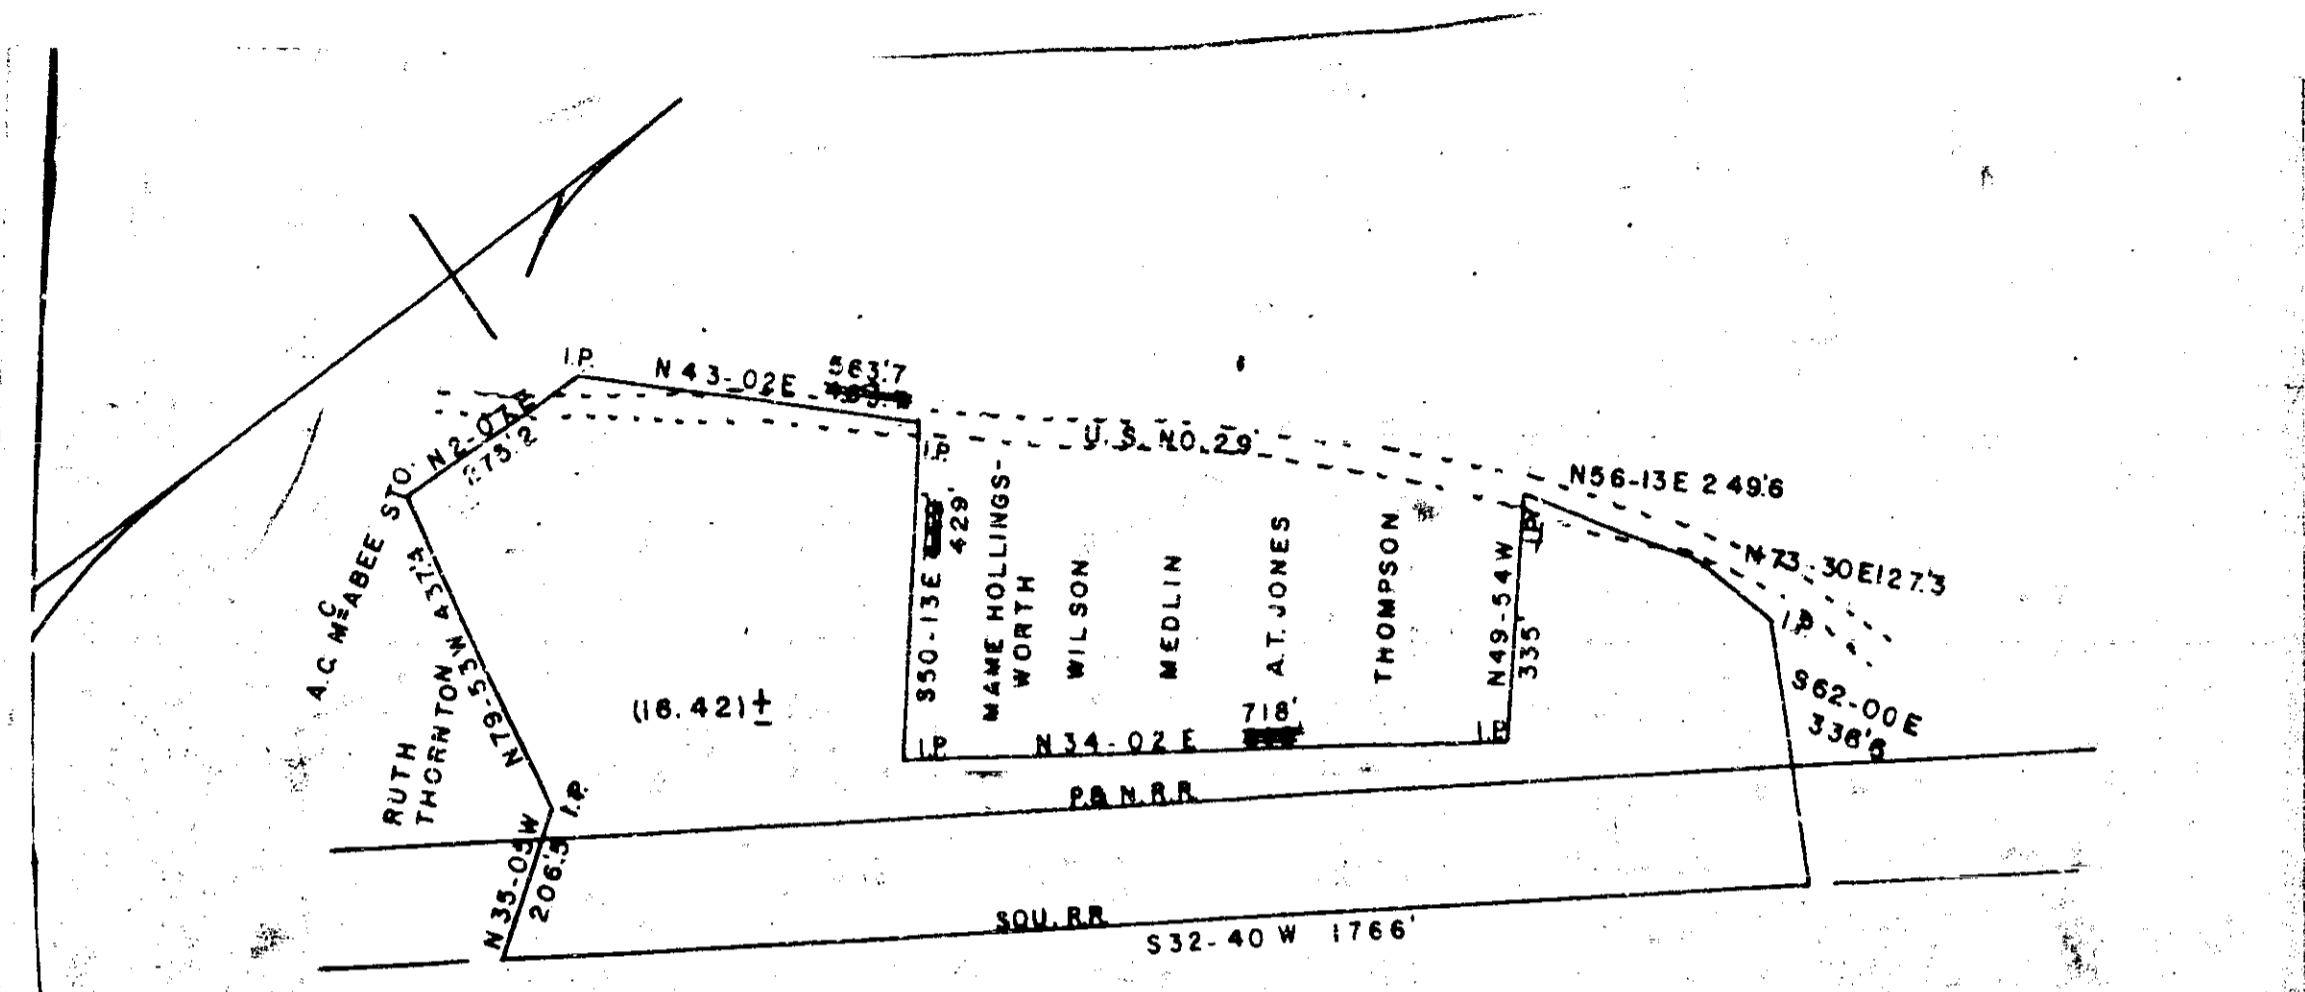

STATE OF SOUTH CAROLINA
- GREENVILLE COUNTY
PLAT OF A PORTION OF SAM M JONES ESTATE. SAID
TRACT IS LOCATED JUST WEST OF PIEDMONT.

REC'D
AUG 2 2 11 PM 1955
GREENVILLE CO. S. C.
CLIVE FARR-SMITH
R. M. S.

SURVEYED APR 4 1955
J. Cole Smith & Son
J COKE SMITH & SON
REG. LS NOS. 974 & 1443

AUG 2 - 1955

19618

B6AP36

1" = 300'

II - 183 .50

#19618
And Recorded in Vol. II Page 183
Clive Farr-Smith
Register of Deeds Greenville County, S. C.

BAD COPY

