


645  
S. J.  
M.

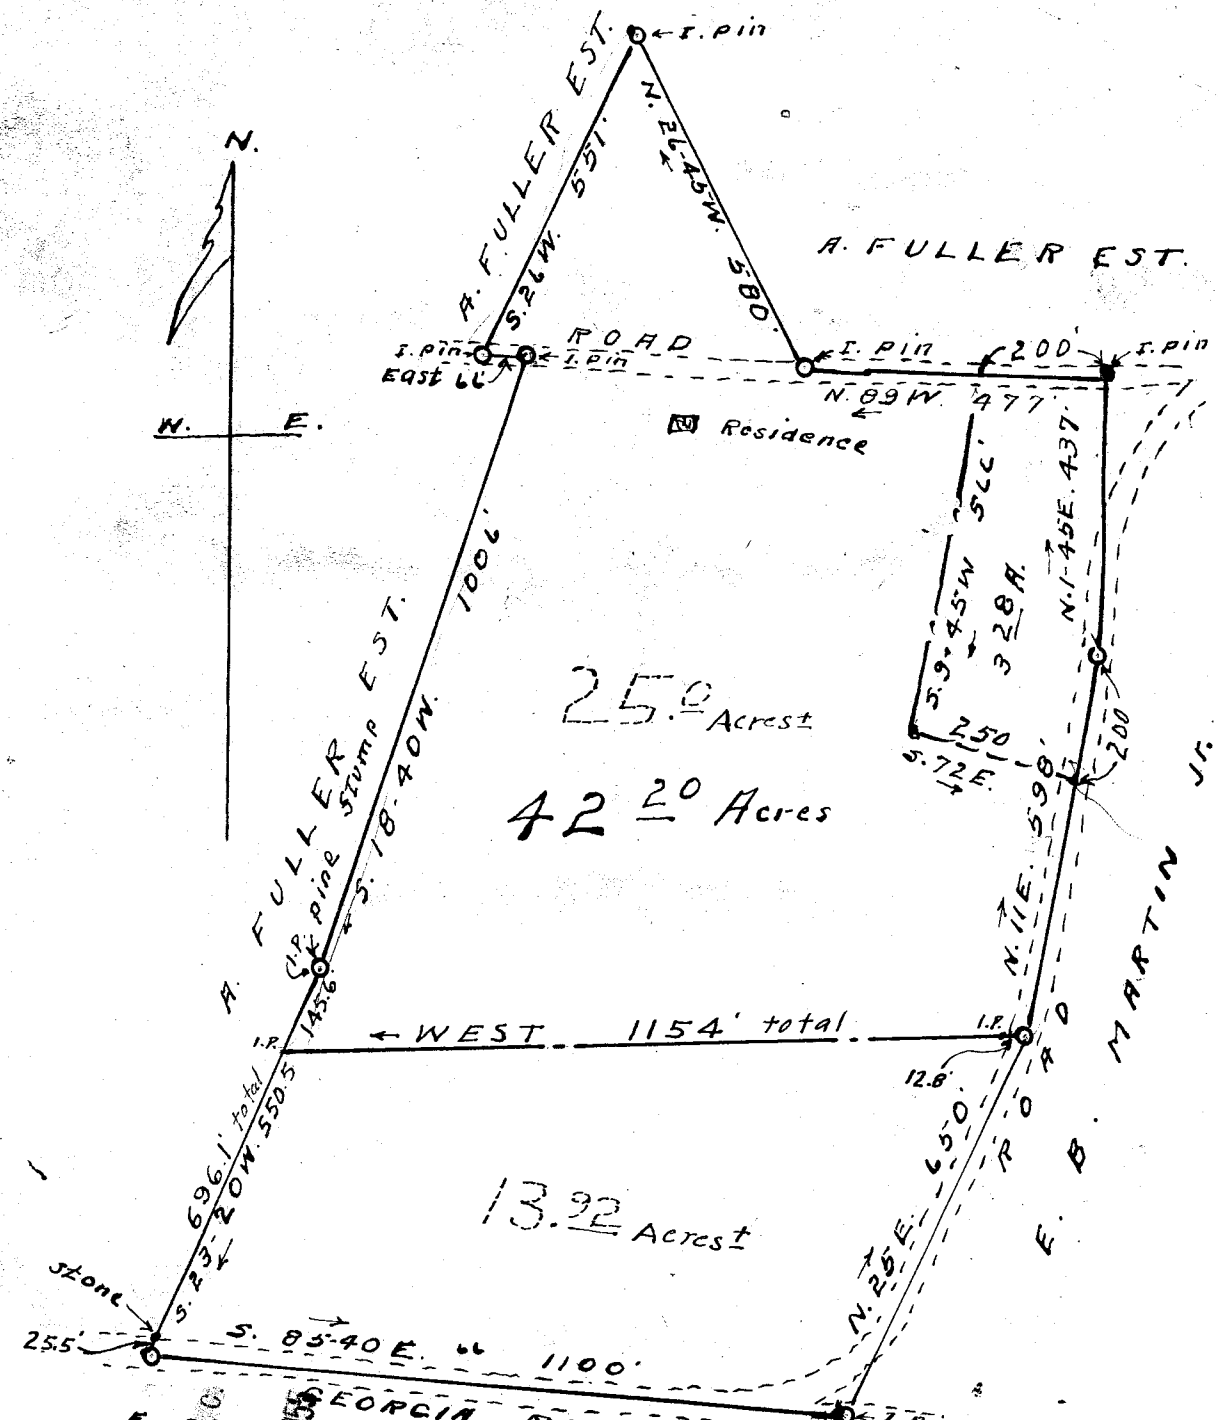

25.0 Acres

42.20 Acres

13.92 Acres

FILED  
GREENVILLE CO. S.C.  
DEC 12 4 58 PM 1955  
OLLIE FARNSWORTH  
R. N.C.

DEC 12 1955

PROPERTY OF  
B. B. YOUNG.

Greenville County S.C. Oct. 12-1935  
Scale 1" = 300'

32070

J.J. 73

Surveyed and plotted by W. J. Riddle

"NOTE" 328 A surveyed and  
Plat revised 12-20-47.  
By W. J. R.  
Plat revised 11/28/55

32070 FILED THE 12th DAY OF Dec 12 55

OLLIE FARNSWORTH  
73

71-20