


U. S. HIGHWAY NO. 29

Piedmont
N 20-40E 199.3
N 14-45E 229.1
Pelzer

J. L. ALLEN
S 44-16E 100.1
S 54-13E 127
Terrace
S 81-20E 112.3
I.P.

Area 1.68 Ac

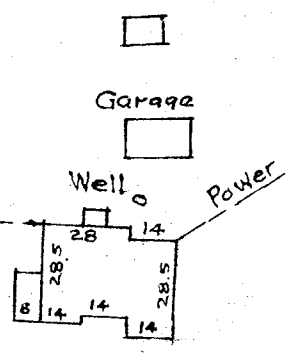

Pole
Elec. Line
Power

COUNTY ROAD
S 43-50W 219.3
S 53-04W 126.9
I.P.


RALPH HARRIS
TERRACE
S 73-36W 56.3
S 61-22W 47.2
S 43-04W 41
N 36-21W 8.85
I.P.

PROPERTY OF
HUBERT WAYNE BENNETT
NEAR PELZER
GREENVILLE CO. S. C.

Scale 1"=60' Jan. 1956

This is to certify that on the 4th day of January, 1956, I surveyed the property shown on this plat; being shown on plat of Hubert Wayne Bennett, Recorded in Plat Book JJ page 95, Office of M. C. Greenville Co., S. C.; and that the property lines, walls and buildings are as shown hereon; that the buildings located on said lot do not encroach or project on adjacent streets or property; and that no adjacent buildings or walls encroach or project on said premises.

GREENVILLE CO. S. C.

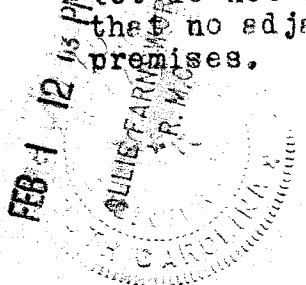

2857

FEB 1 1956

JJ = 95

K.W. Dutton
Registered.

300

Filed This 1st day of Feb 1956
and Recorded in Vol. JJ Page 95 at 12:03 P.M.
Ollie Farnsworth
Register Means Conveyance Greenville County, S. C.