


# Plat Book - JJ - Page 157B

REF: PLAT OF PROPERTY OF KAY E. MEALISTER, FILED IN PL. BK. S PAGE 157  
 PLAT OF PROPERTY OF J. S. GARRETT, FILED IN PL. BK. T PAGE 233  
 PLAT OF WILLIAM R. & MARGARET W. BATSON, FILED IN PL. BK. 'JJ' PAGE 157.

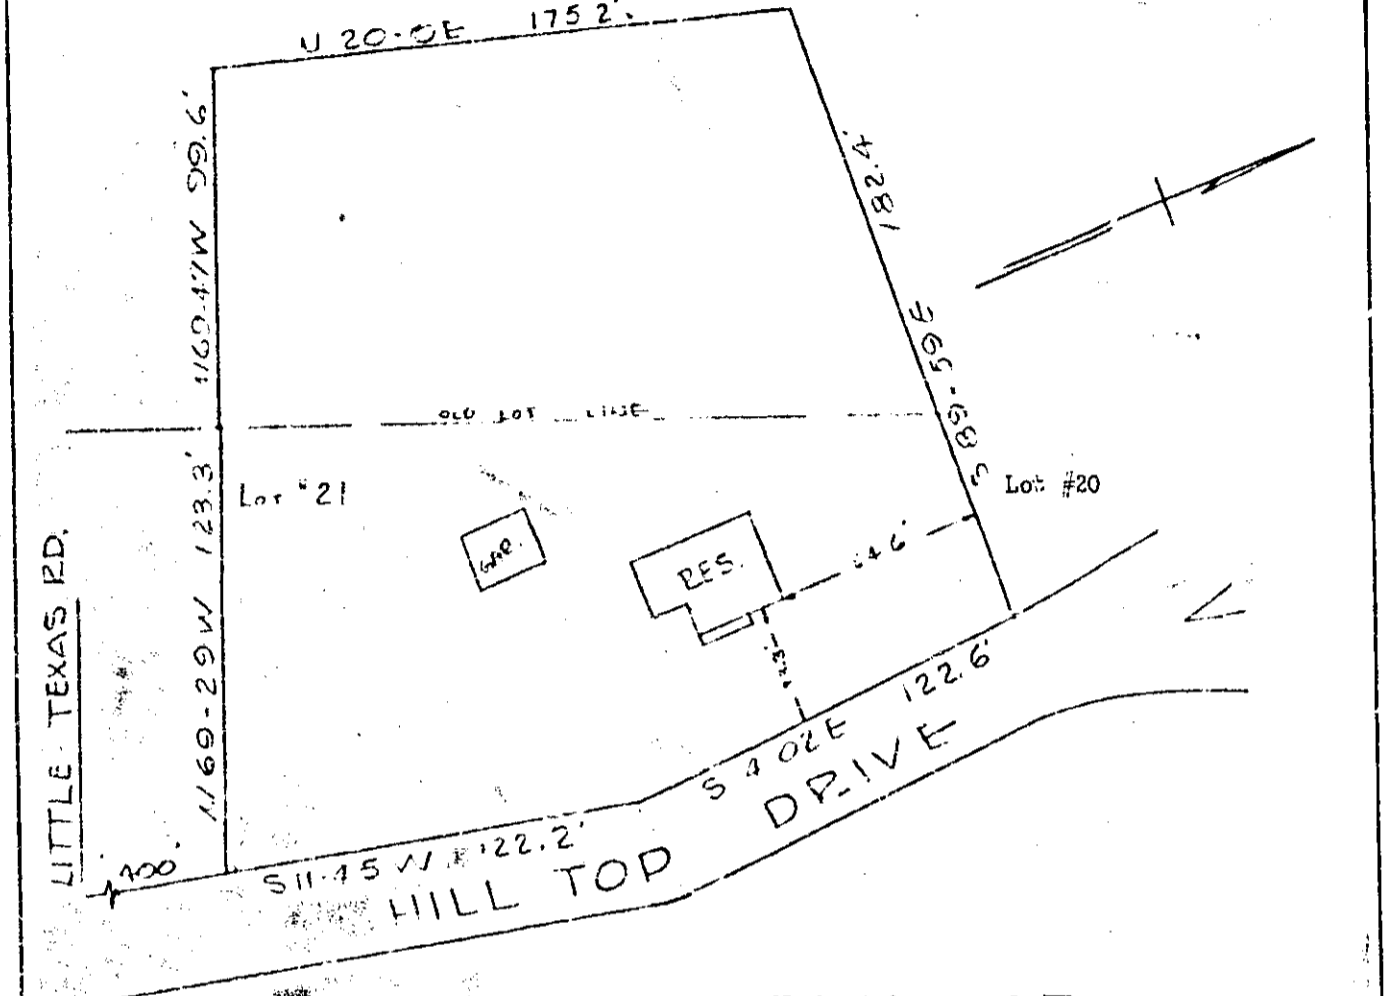

PROPERTY OF  
 WILLIAM RALPH & MARGARET W. BATSON  
 NEAR TRAVELERS REST, S.C.  
 SCALE: 1 IN = 50 FT      MARCH 28, 1956

This is to certify that on the 28th day of March, 1956, I surveyed the property shown on this plat; and that the property lines, walls and buildings are as shown hereon; that the buildings located on said lot do not encroach or project on adjacent streets or property; and that no adjacent walls or buildings encroach or project on this lot; and that there are no utility lines crossing this property except as shown.

*E. E. Gandy*  
 Registered Engineer No. 962



PIEDMONT ENGINEERING SERVICE  
 GREENVILLE S C

MAR 29 1956 8095

88-157

# 8095 Plat This 29<sup>th</sup> of March 1956  
 and Recorded in Vol. 88 Page 157 of 110  
*Ollie Samworth*  
 Registrar of Deeds (Attorney General's Office) Greenville, S.C.