

# Plat Book-QQ-Page 4 C

LOT REVISION APPROVED  
 PLANNING AND ZONING COMMISSION  
 CITY HALL GREENVILLE S. C.


Feb. 11, 1959 *E. J. ... Jr.*  
*Director*

FILED  
 GREENVILLE CO. S. C.

FEB 11 10 30 AM 1959  
 GREENVILLE COUNTY SCHOOLS

 R.M.C.

HUDSON ROAD

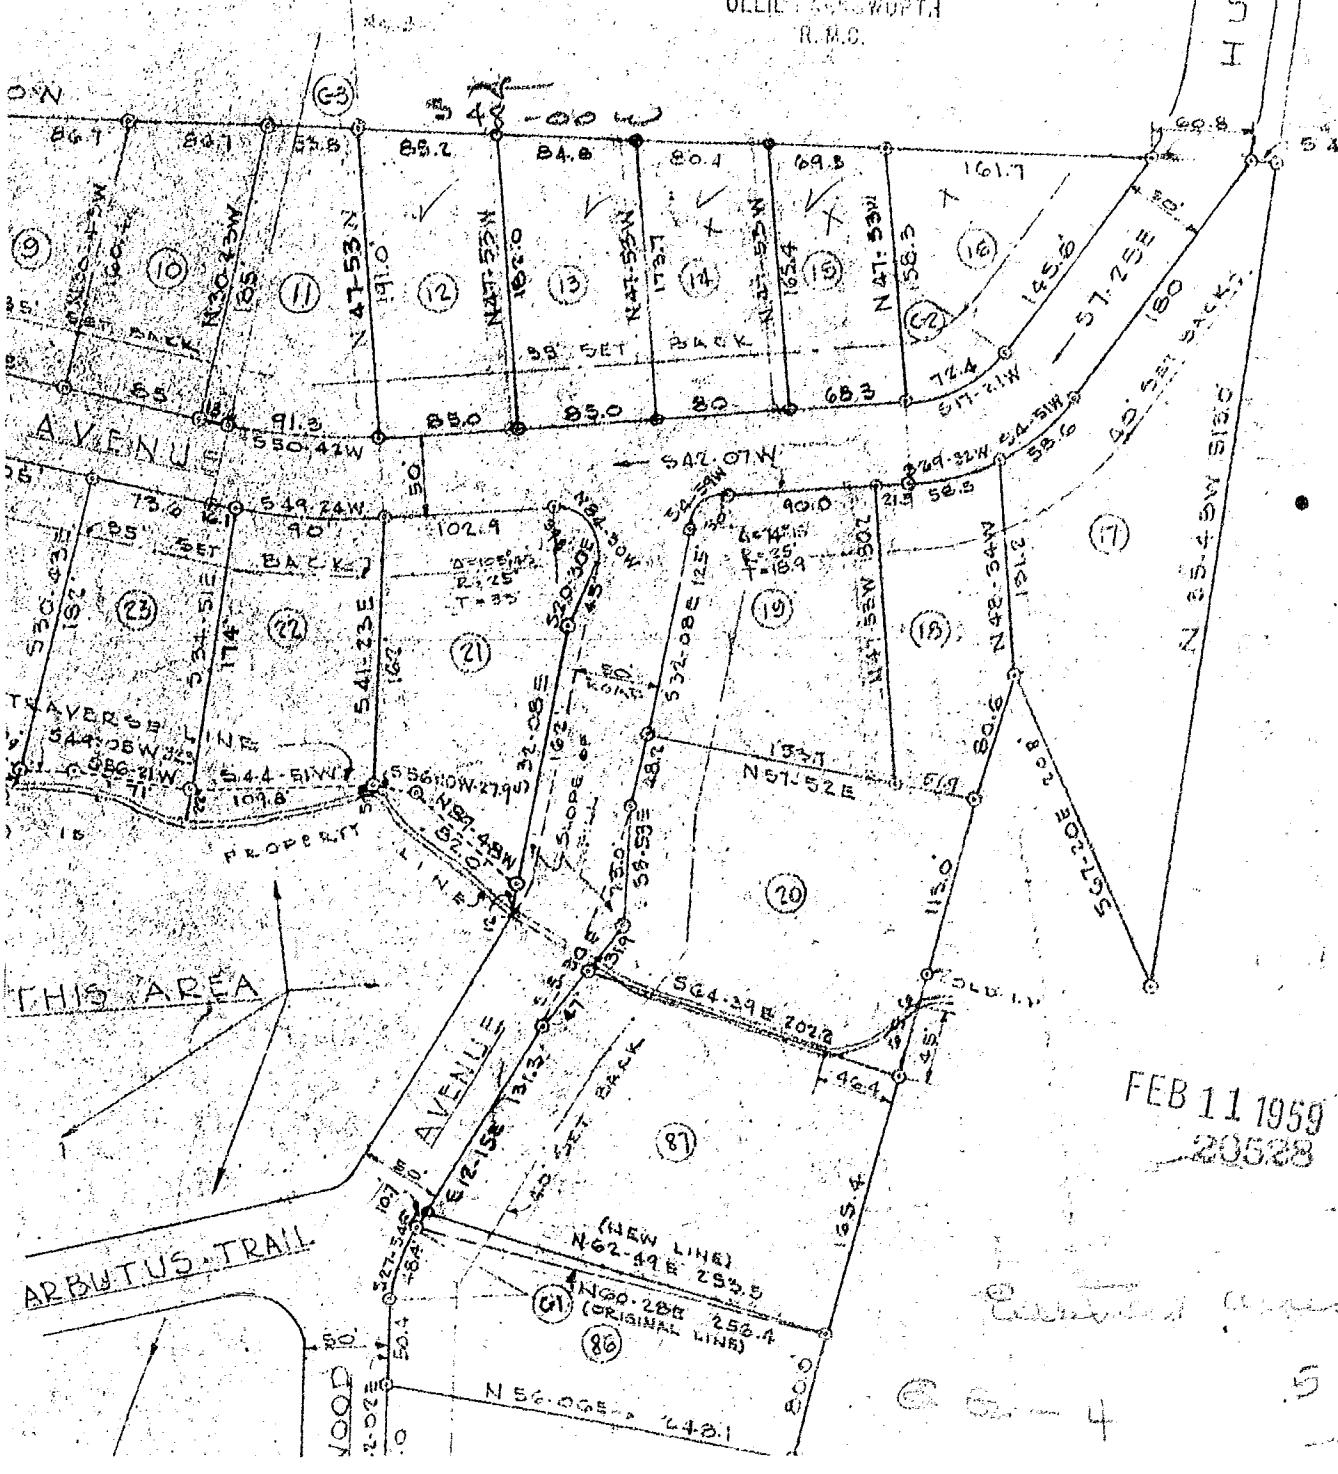

FEB 11 1959  
 20538

and Forwarded to Vol. QQ-Page 4 of  
*Edna S. ...*  
 Registrar of Deeds, Greenville County, S. C.

ARBUTUS TRAIL

50