


Plat Book-R R-Page 109

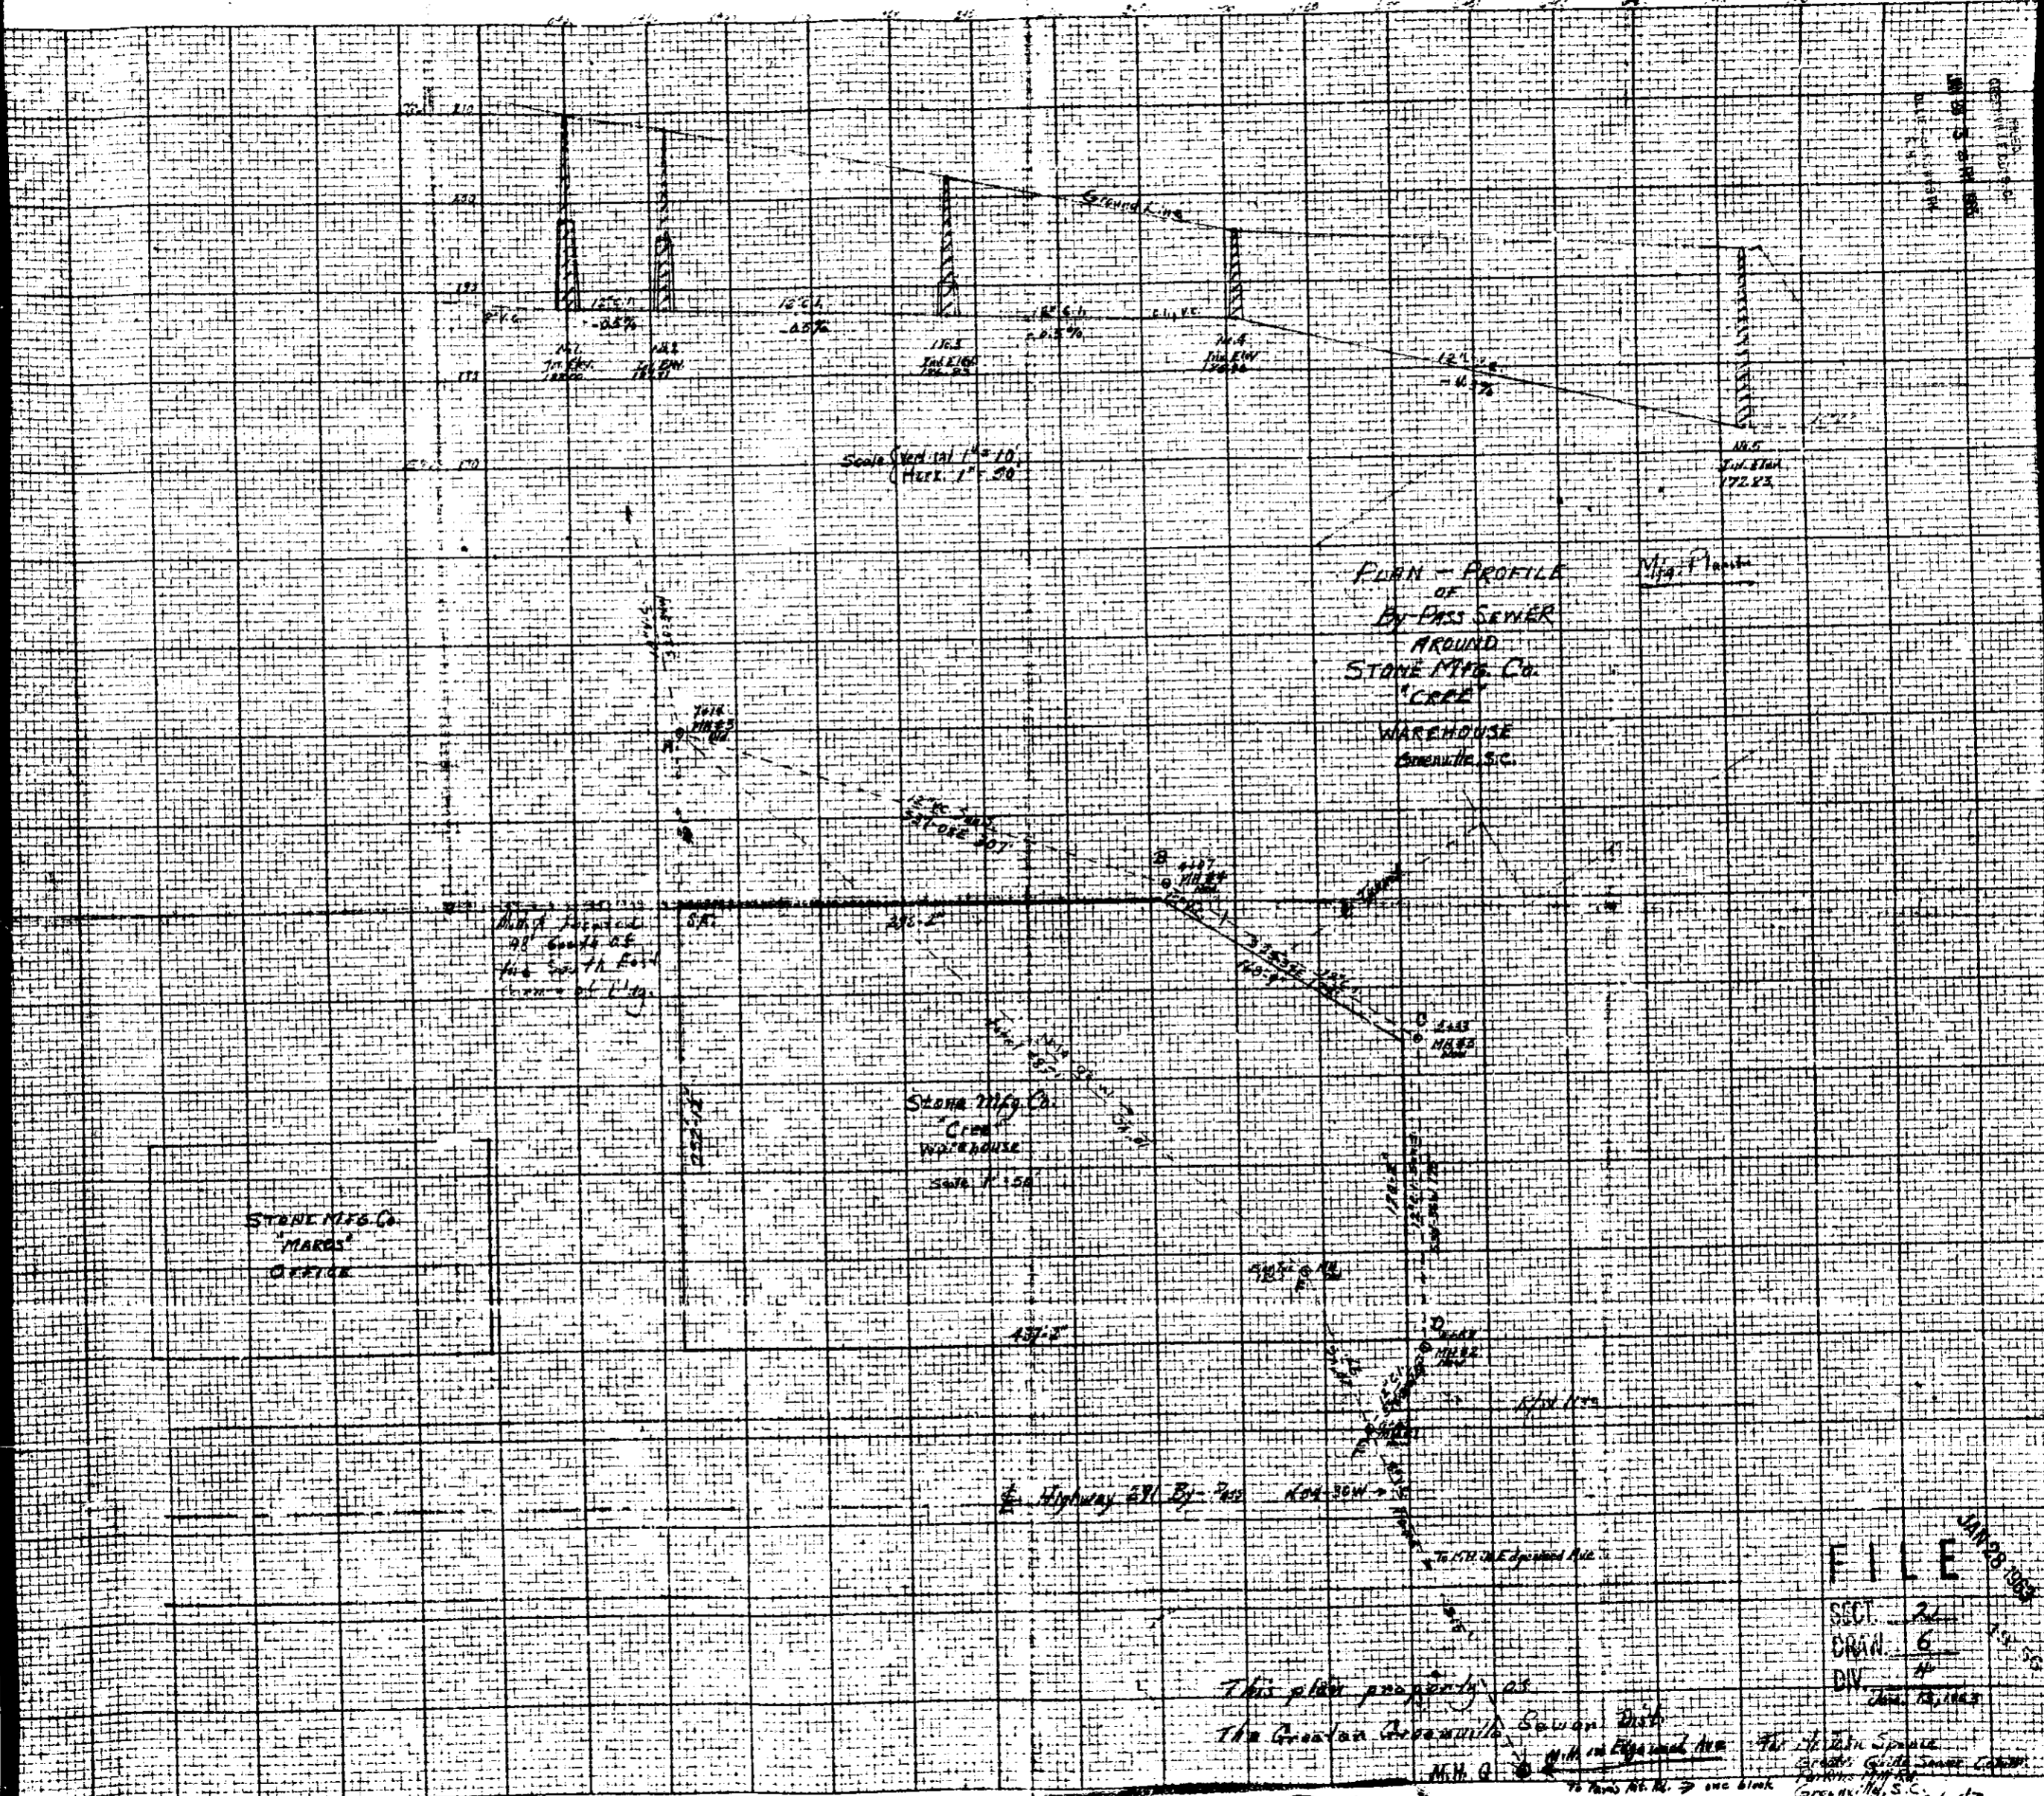


FILE
 SECT. 2
 DRAW. 6
 DIV. 4

This plan properly as
 The Greater Greenville Sewer Dist.
 with in Edgewood Ave.
 M.H. Q


BAD COPY