Plat Book SS, Page 1 B

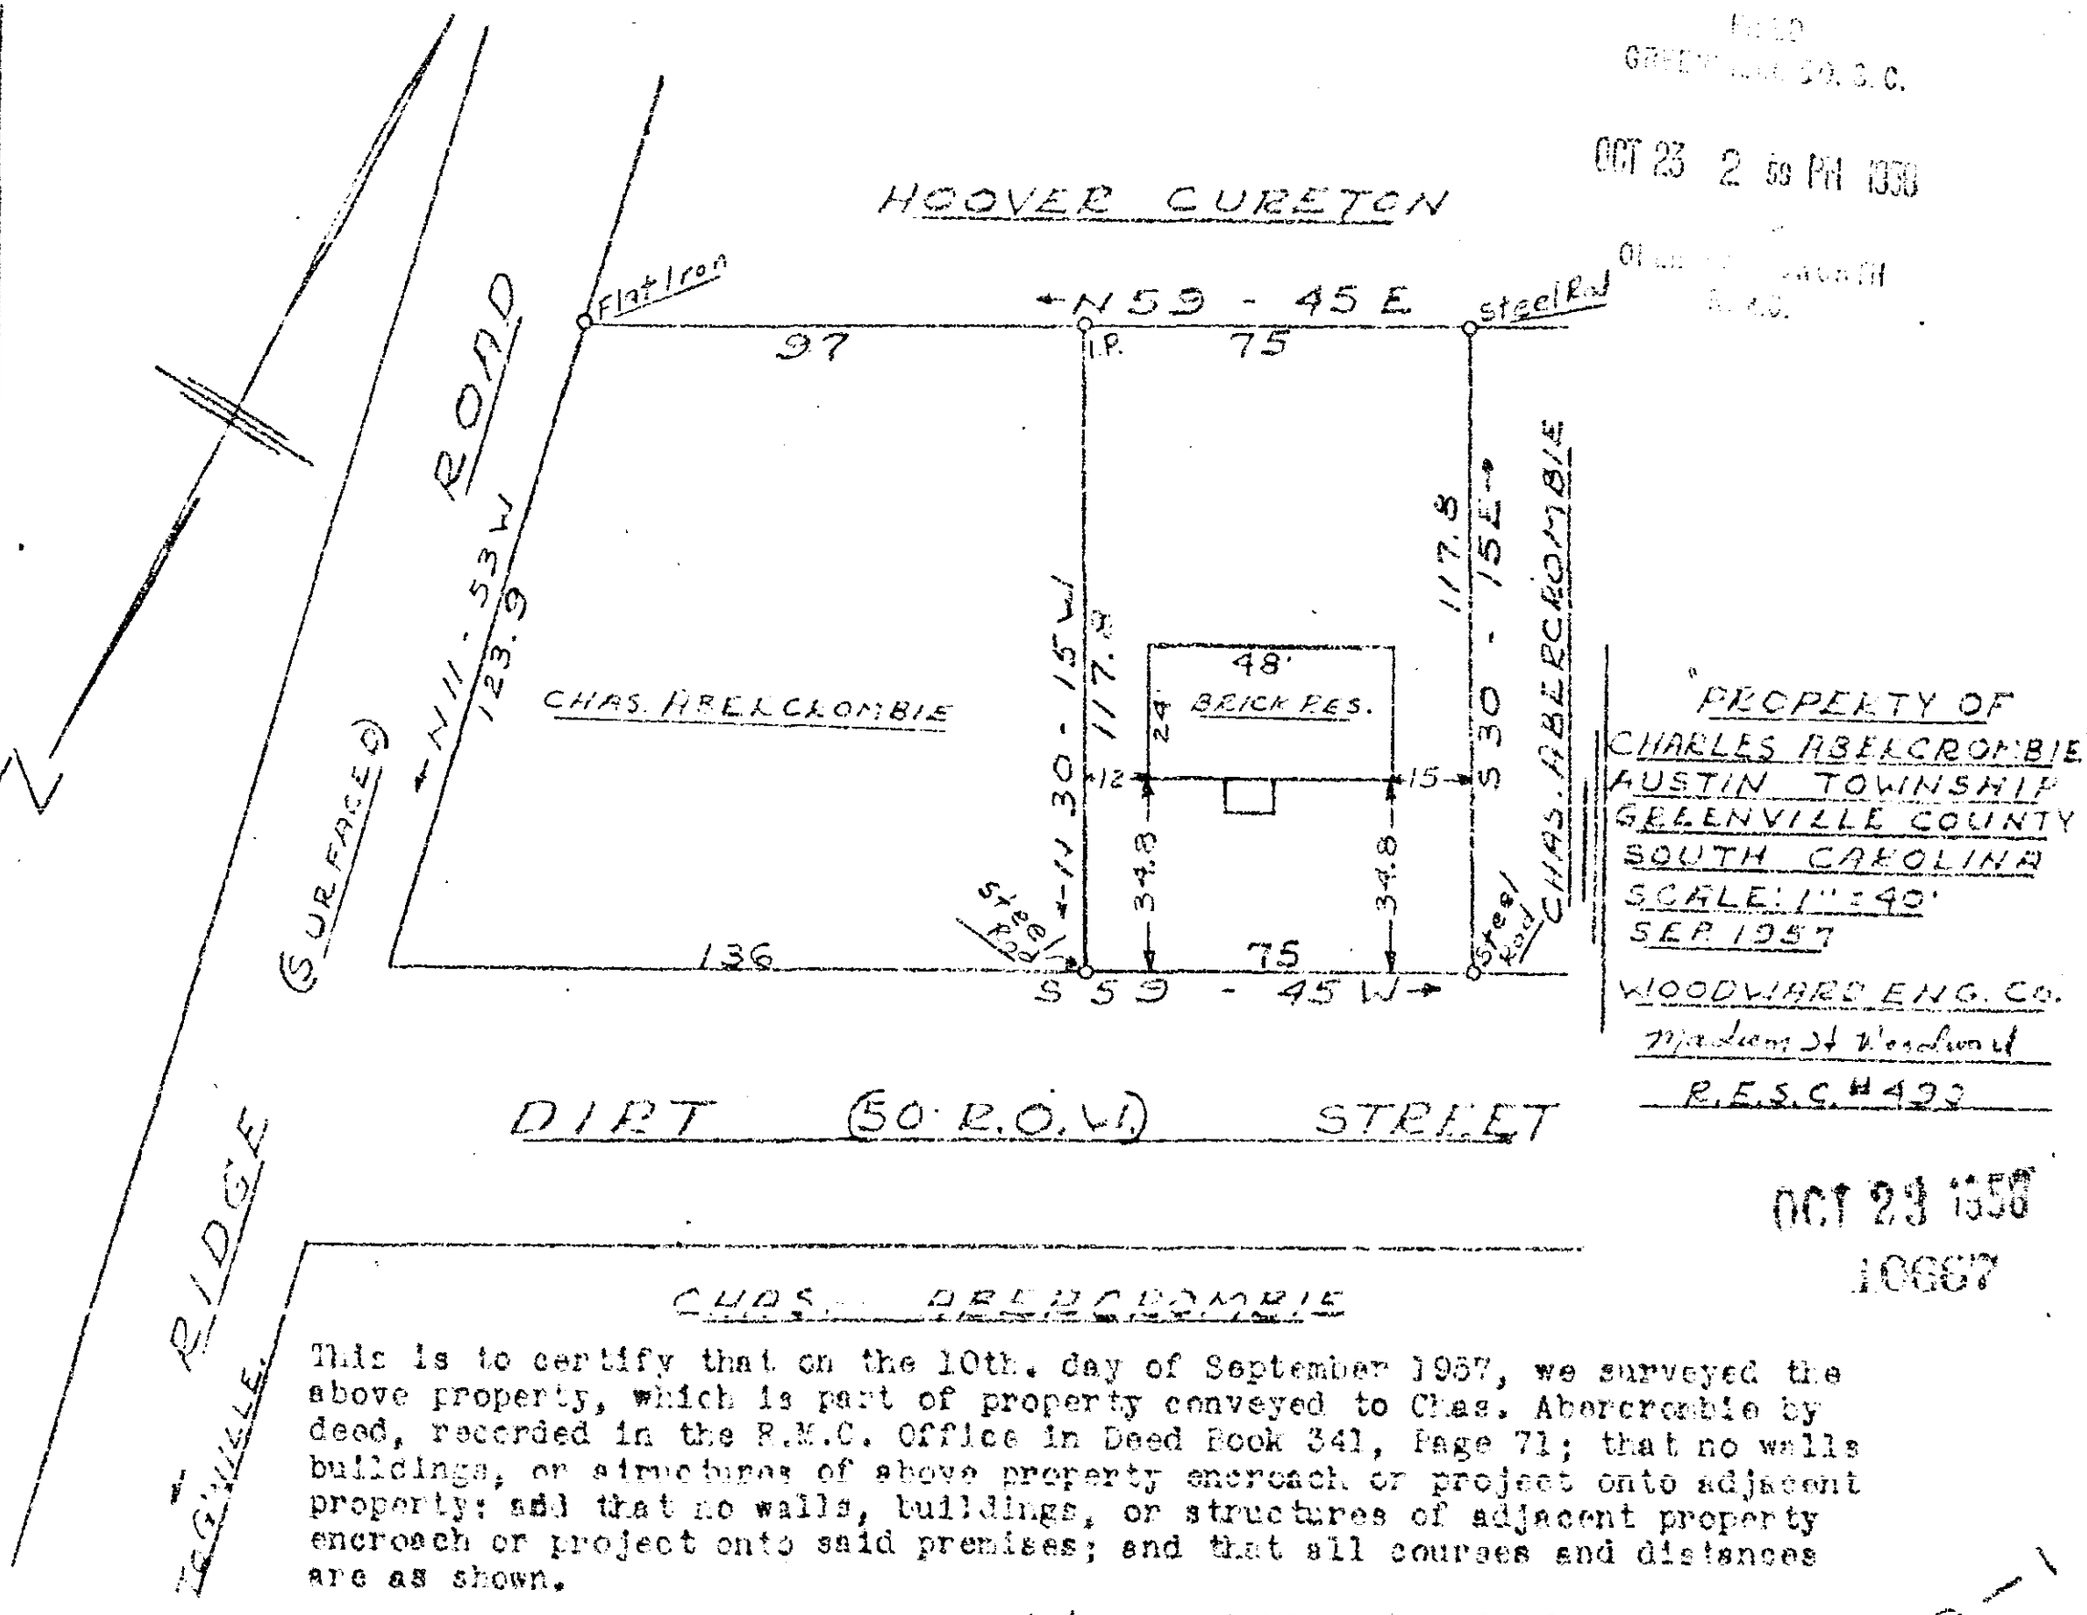

"PROPERTY OF
CHARLES ABERCROMBIE
AUSTIN TOWNSHIP
GREENVILLE COUNTY
SOUTH CAROLINA
SCALE: 1" = 40'
SEP 1957
WOODWARD ENG. CO.
Madison H Woodward
R.E.S.C. #490

OCT 23 2 59 PM 1958

OCT 23 1958
10667

CHAS. ABERCROMBIE

This is to certify that on the 10th. day of September 1957, we surveyed the above property, which is part of property conveyed to Chas. Abercrombie by deed, recorded in the R.M.C. Office in Deed Book 341, Page 71; that no walls buildings, or structures of above property encroach or project onto adjacent property; and that no walls, buildings, or structures of adjacent property encroach or project onto said premises; and that all courses and distances are as shown.

WOODWARD ENG. CO.

Madison H Woodward, RESC 490

BY J. MAC RICHARDSON L.S. 598

10667 Plat Thru 23 Day of Oct 1958
Ind Recorded in Vol. SS Page 1 of
Register Mesne Conveyance Greenville County, S.C.