


Plat Book SS. Page 70

OAK CREST SUBDIVISION

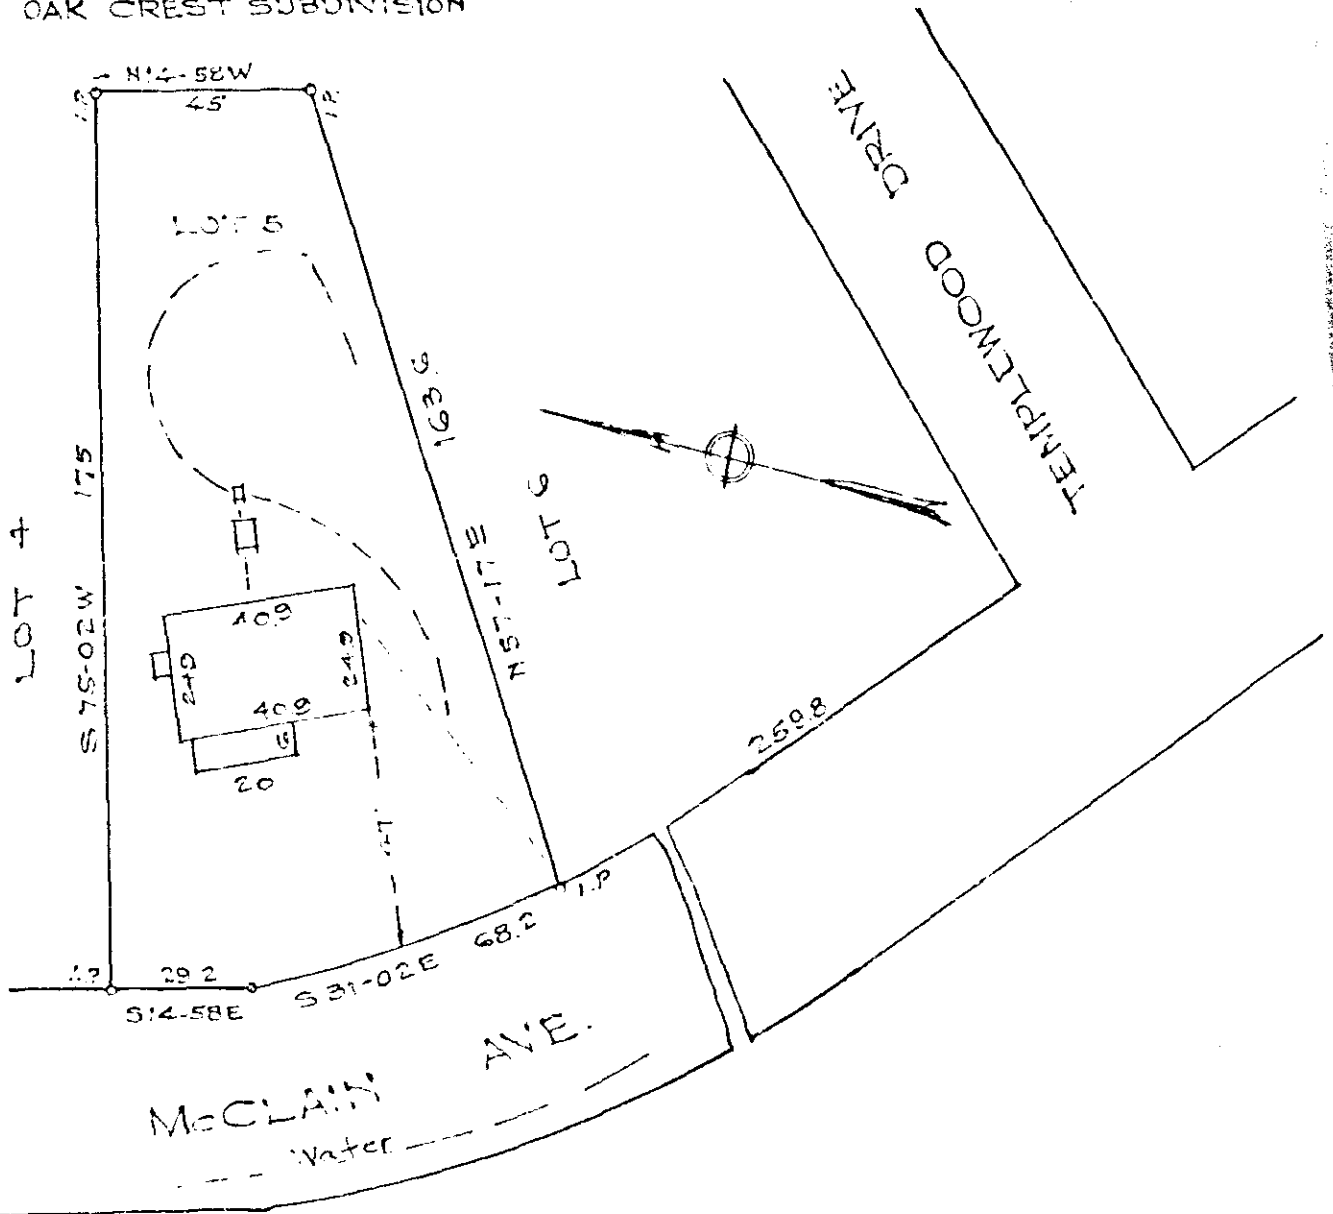

PROPERTY OF
DAVID L. FLEMING
NEAR GREENVILLE S. C.
Scale 1"=40' Dec. 1958

This is to certify that on the 9th day of December, 1958, I surveyed the property shown on this plat; being known as Lot 5 on plat of David L. Fleming, Recorded in Plat Book SS page 51, Office of R. M. C. Greenville Co., S. C.; and that the property lines, walls and buildings are as shown hereon; that the buildings located on said lot do not encroach or project on adjacent streets or property; and that no adjacent buildings or walls encroach or project on said premises; and that no utility lines cross this property except as shown hereon.

DEC 11 1958

R. W. Hatton

Registered.

14779
M.C. GREENVILLE
H.L. FLEMING

14779

SS-70

14779 Filed This 11 day of Dec. 19 58

and Recorded in Plat Book SS Page 70 of

Allen F. Stewart

Register of Public Conveyances Greenville County, S. C.