Plat Book SS, Page 76

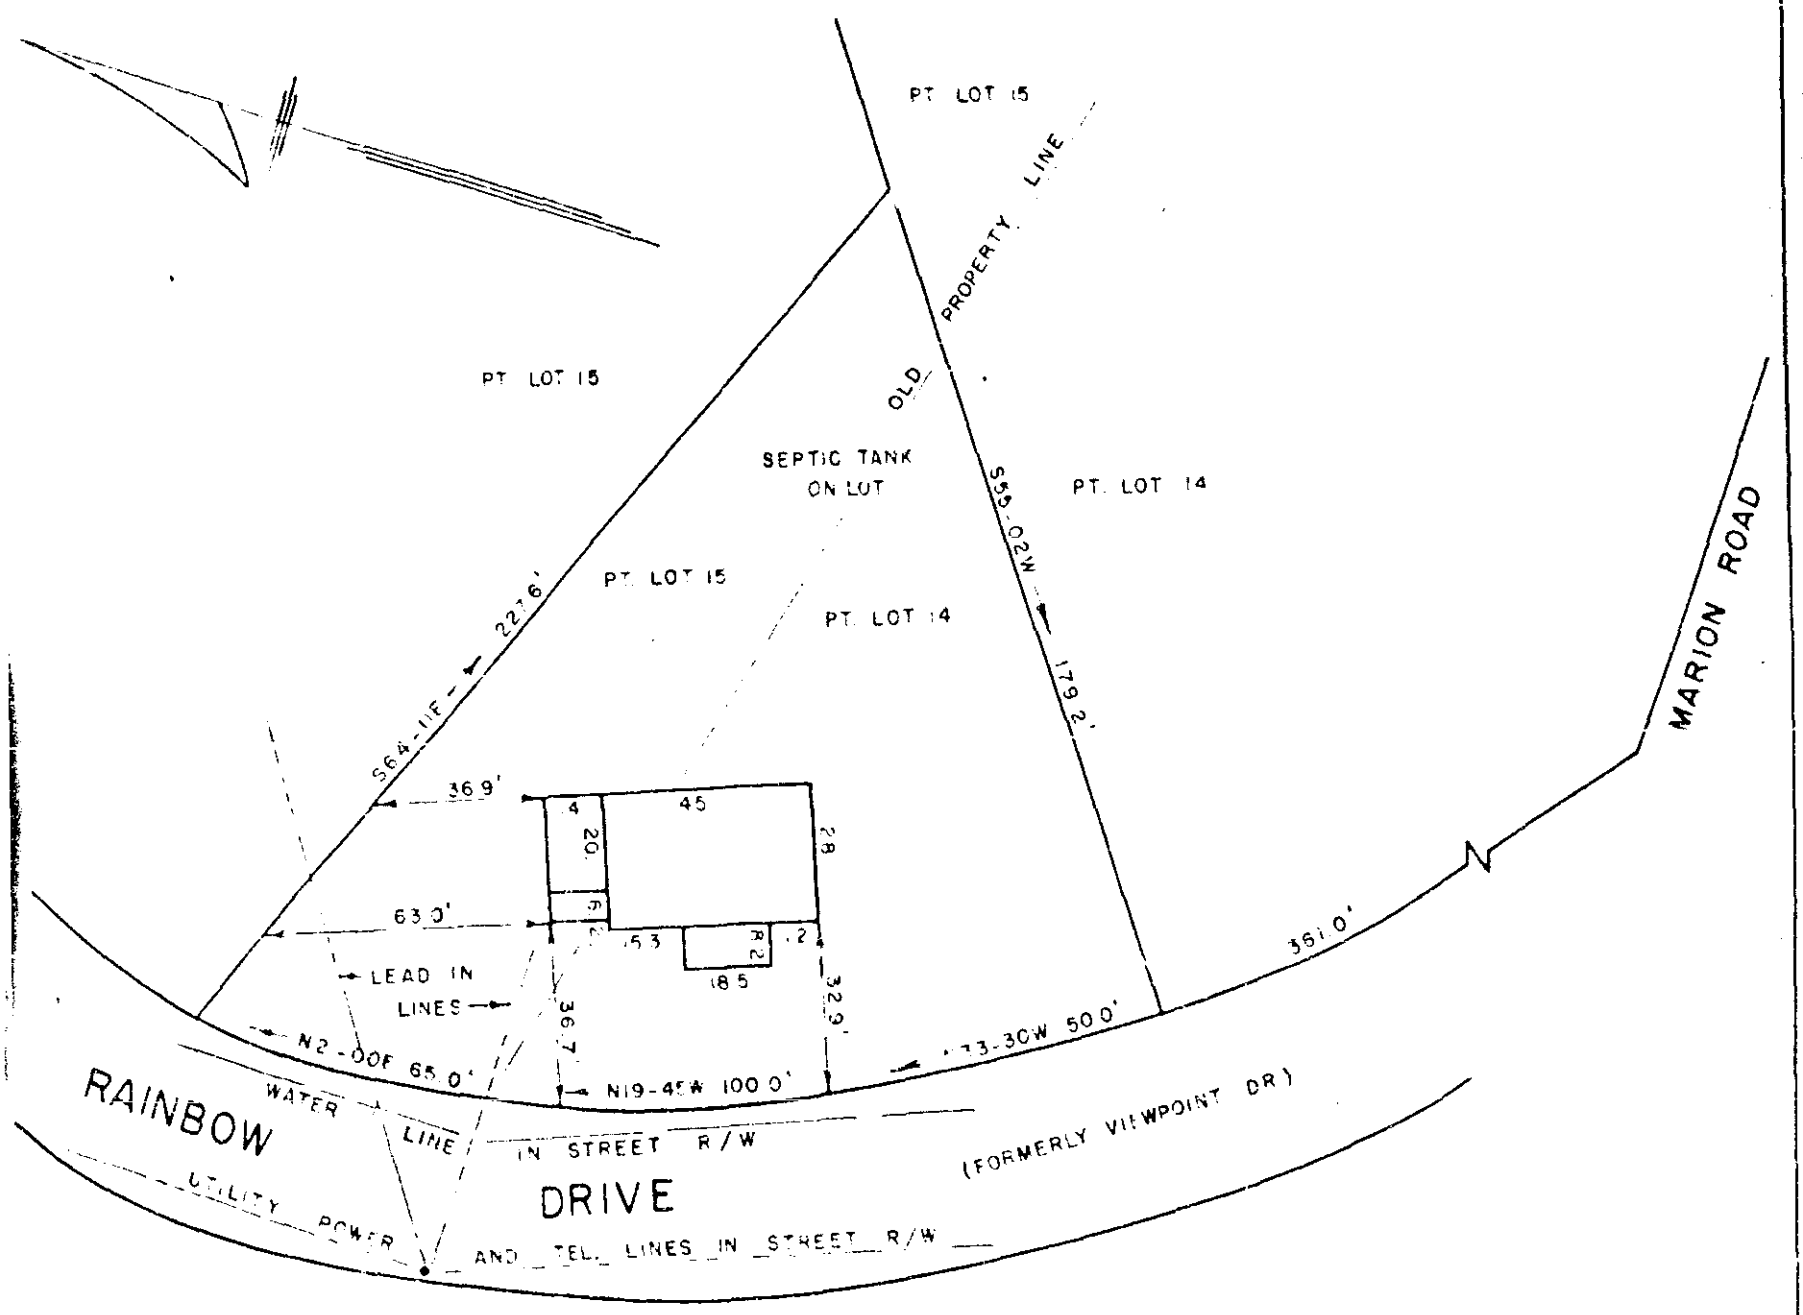

PROPERTY OF
OLIN D. LAWS And
SHIRLEY B. LAWS
NEAR GREENVILLE, S.C.
SCALE 1" = 50' 7 JAN. 1959

This is to certify that on the 7th day of Jan. 1959, I surveyed the property shown on this plat, being known as portions of lots 14 & 15, property of Eliza D. Ware recorded in R.M.C. office Greenville County, in plat book M page 27, and that the property lines, walls and buildings are as shown hereon, and that the buildings located on said lot do not encroach or project on adjacent street or property, and that no adjacent buildings or walls encroach or project on said premises, and that no utility lines cross this property except as shown hereon.

R. B. Bruce
R.B.Bruce, R.L.S. No 1952

17217
JAN 8 1959

SS-76

TEN 1 2 3 4 5 6

#17217 Filed This 8 day of Jan 1959
And Recorded in Vol SS Page 76 of M.
Bessie Finsworth
Register Mesne Conveyance Greenville County, S.C.