


Plat Book SS, Page 151A

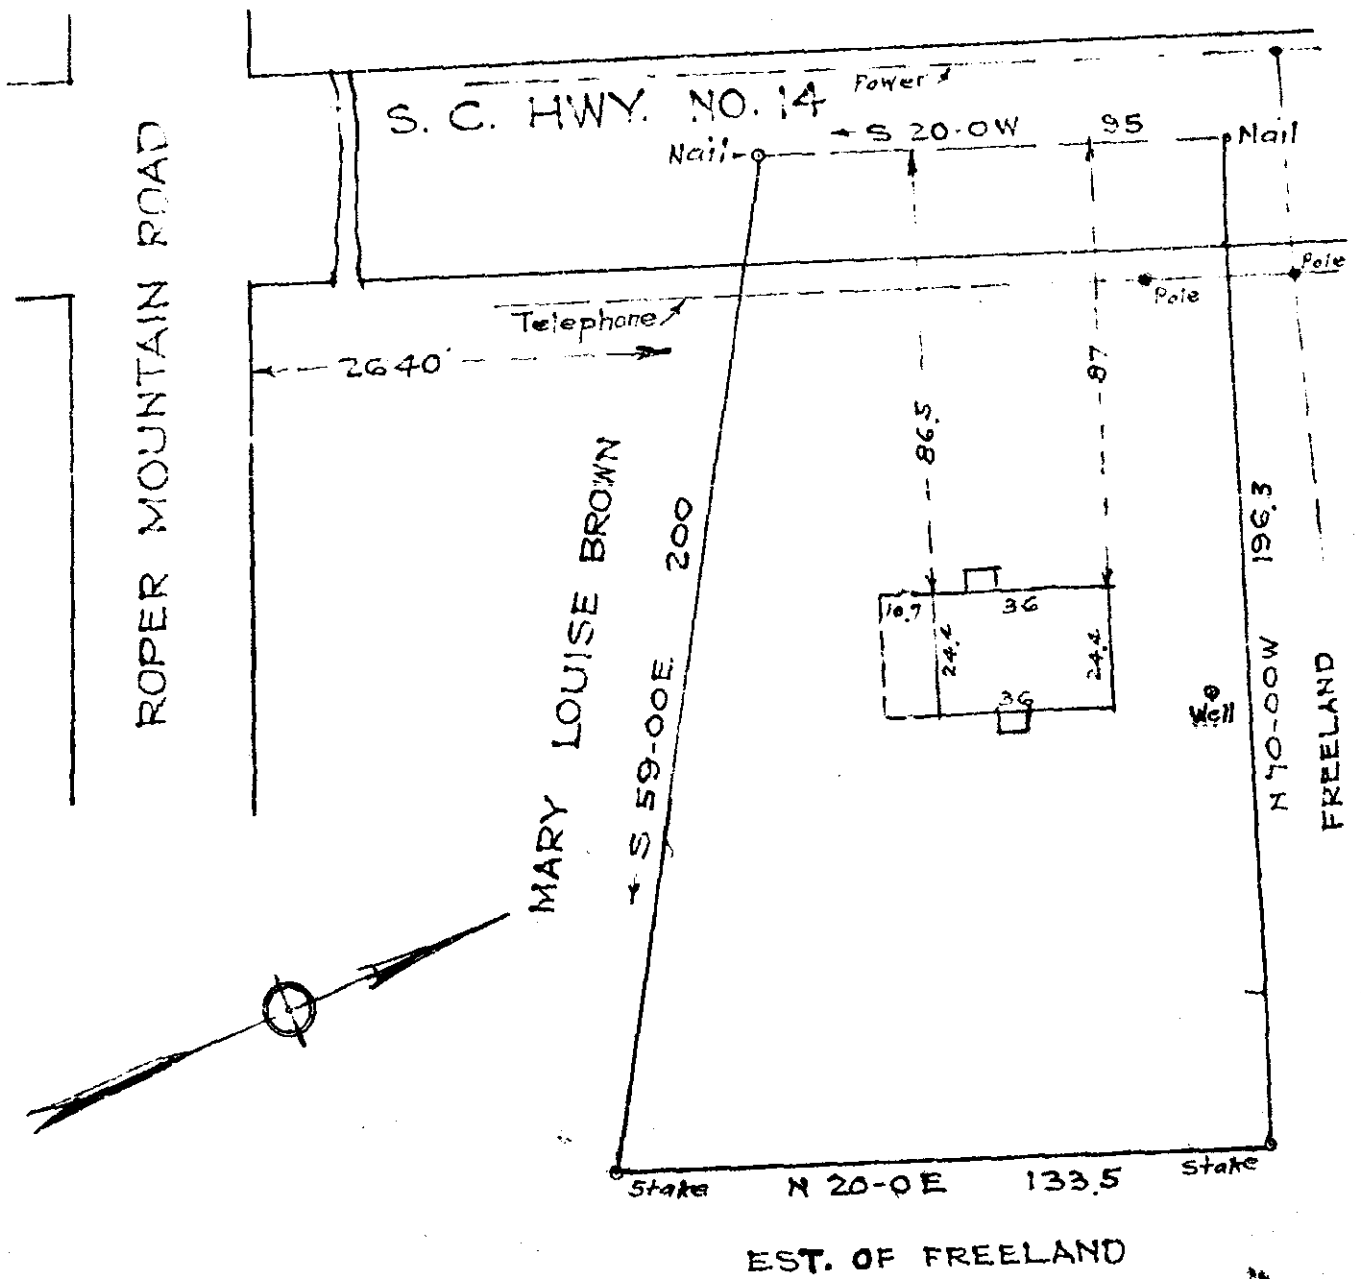

PROPERTY OF
 W. P. SMITH
 JUNE ELIZABETH FREELAND SMITH
 GREENVILLE CO. S.C.

Scale 1"=40' April 1959

This is to certify that on the 24th day of April, 1959, I surveyed the property shown on this plat; and that the property lines, walls and buildings are as shown hereon; that the buildings located on said lot do not encroach or project on said adjacent streets or property; and that no adjacent buildings or walls encroach or project on said premises; and that no utility lines cross this property except as shown hereon.

R. W. Dalton
 Registered.

APR 24 1959

SS-151
 509

27964

316

27964 Filed This 24th day of April 1959
 and Recorded in Vol. 33 Page 151A
 Register Marie Conner Greeneville County, S. C.