


Plat Book UU, Page 3A

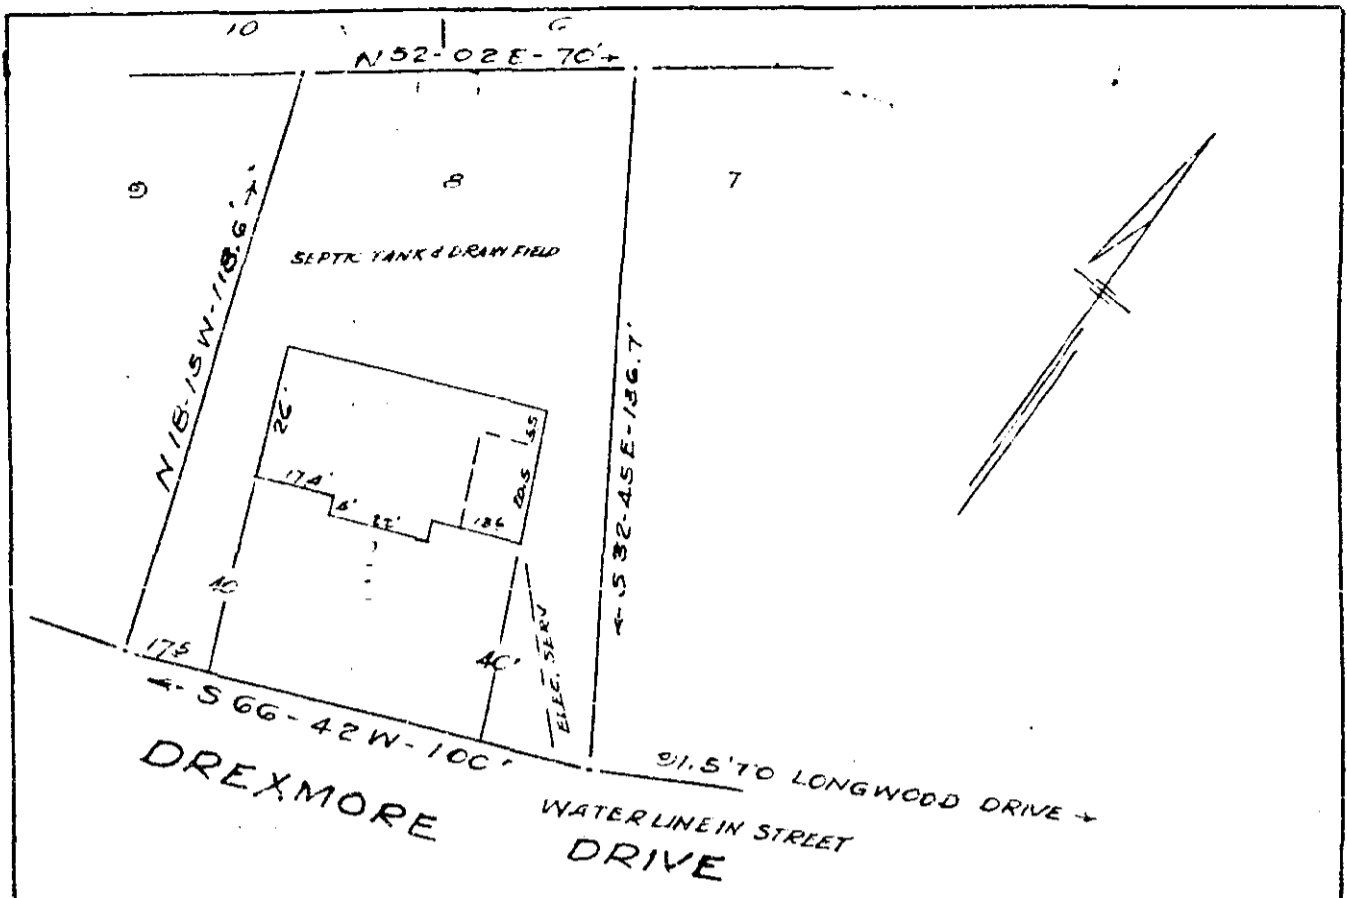

PROPERTY OF
GILES A. MYERS
 NEAR GREENVILLE, S. C.
 MAY 9, 1960 SCALE 1"=40'

This is to certify that on the 9th day of May 1960 I surveyed the property shown on this plat being known as lot number 8 on Plat of Thornwood Acres, by CC Jones, December 1, 1958 and recorded in Plat Book MM at page 59, Office of the R.M.C. for Greenville County, South Carolina; and also more recently by a Plat of the Giles A. Myers property by T. C. Adams, recorded in Plat Book at page ; and that the property lines, walls and buildings are as shown hereon; and that there are no projections or encroachments other than shown.

T. C. Adams
 T. C. Adams
 Reg. Engineer 307.

MAY 16 1960

UU-3 31357

31357 Filed This 16 day of May 1960
 and Recorded in Vol. UU Page 3 at
Carrie R. [Signature]
 Register & Notary Conveyance Greenville County, S. C.

GILES A. MYERS