

2250

44-10


34616

JUN 16 1960

No Encroachments on Lot

DR. R. N. BROWN

AREA = 4.6 ACRES.
New 6 Room - Brick veneer
& Garage Residence
Under Construction.
Jerry S. Die

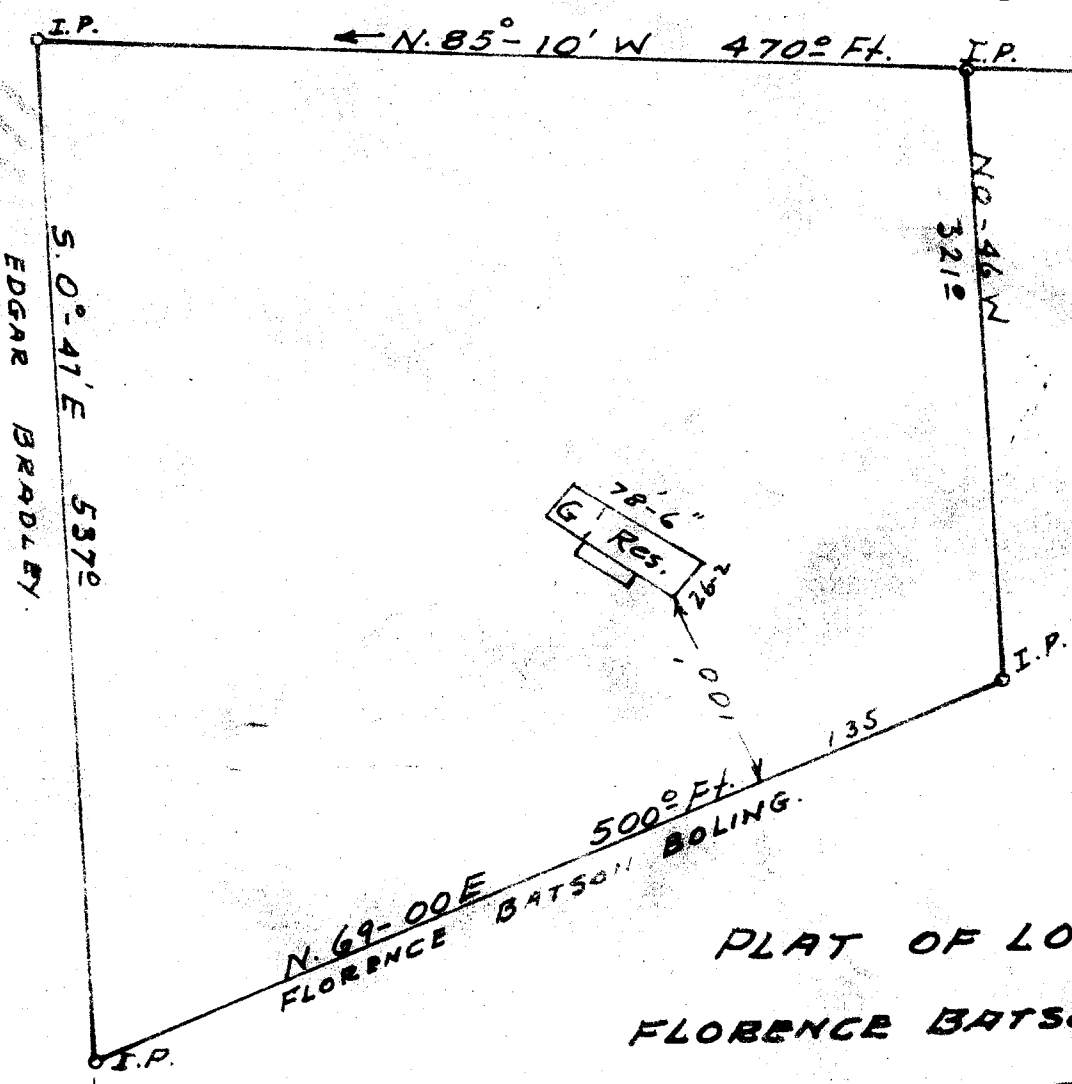

OLLIE FARRIS WORTH
R.M.O.

JUN 16 4 16 PM 1960

PLAT OF LOT OF
FLORENCE BATSON BOLING

CHICK SPRINGS TWP. GREENVILLE CO

SOUTH CAROLINA

JUNE 8, 1960

SURVEY BY
Jerry S. Die
Reg. E & L S #104

OAK I.P.

34616. Filed This 16 day of June 19 60
And Recorded in Vol. 44 Page 101 at

Ollie Farris Worth
Register Meane Conveyance Greenville County, S. C.