Plat Book UU, Page 21 B

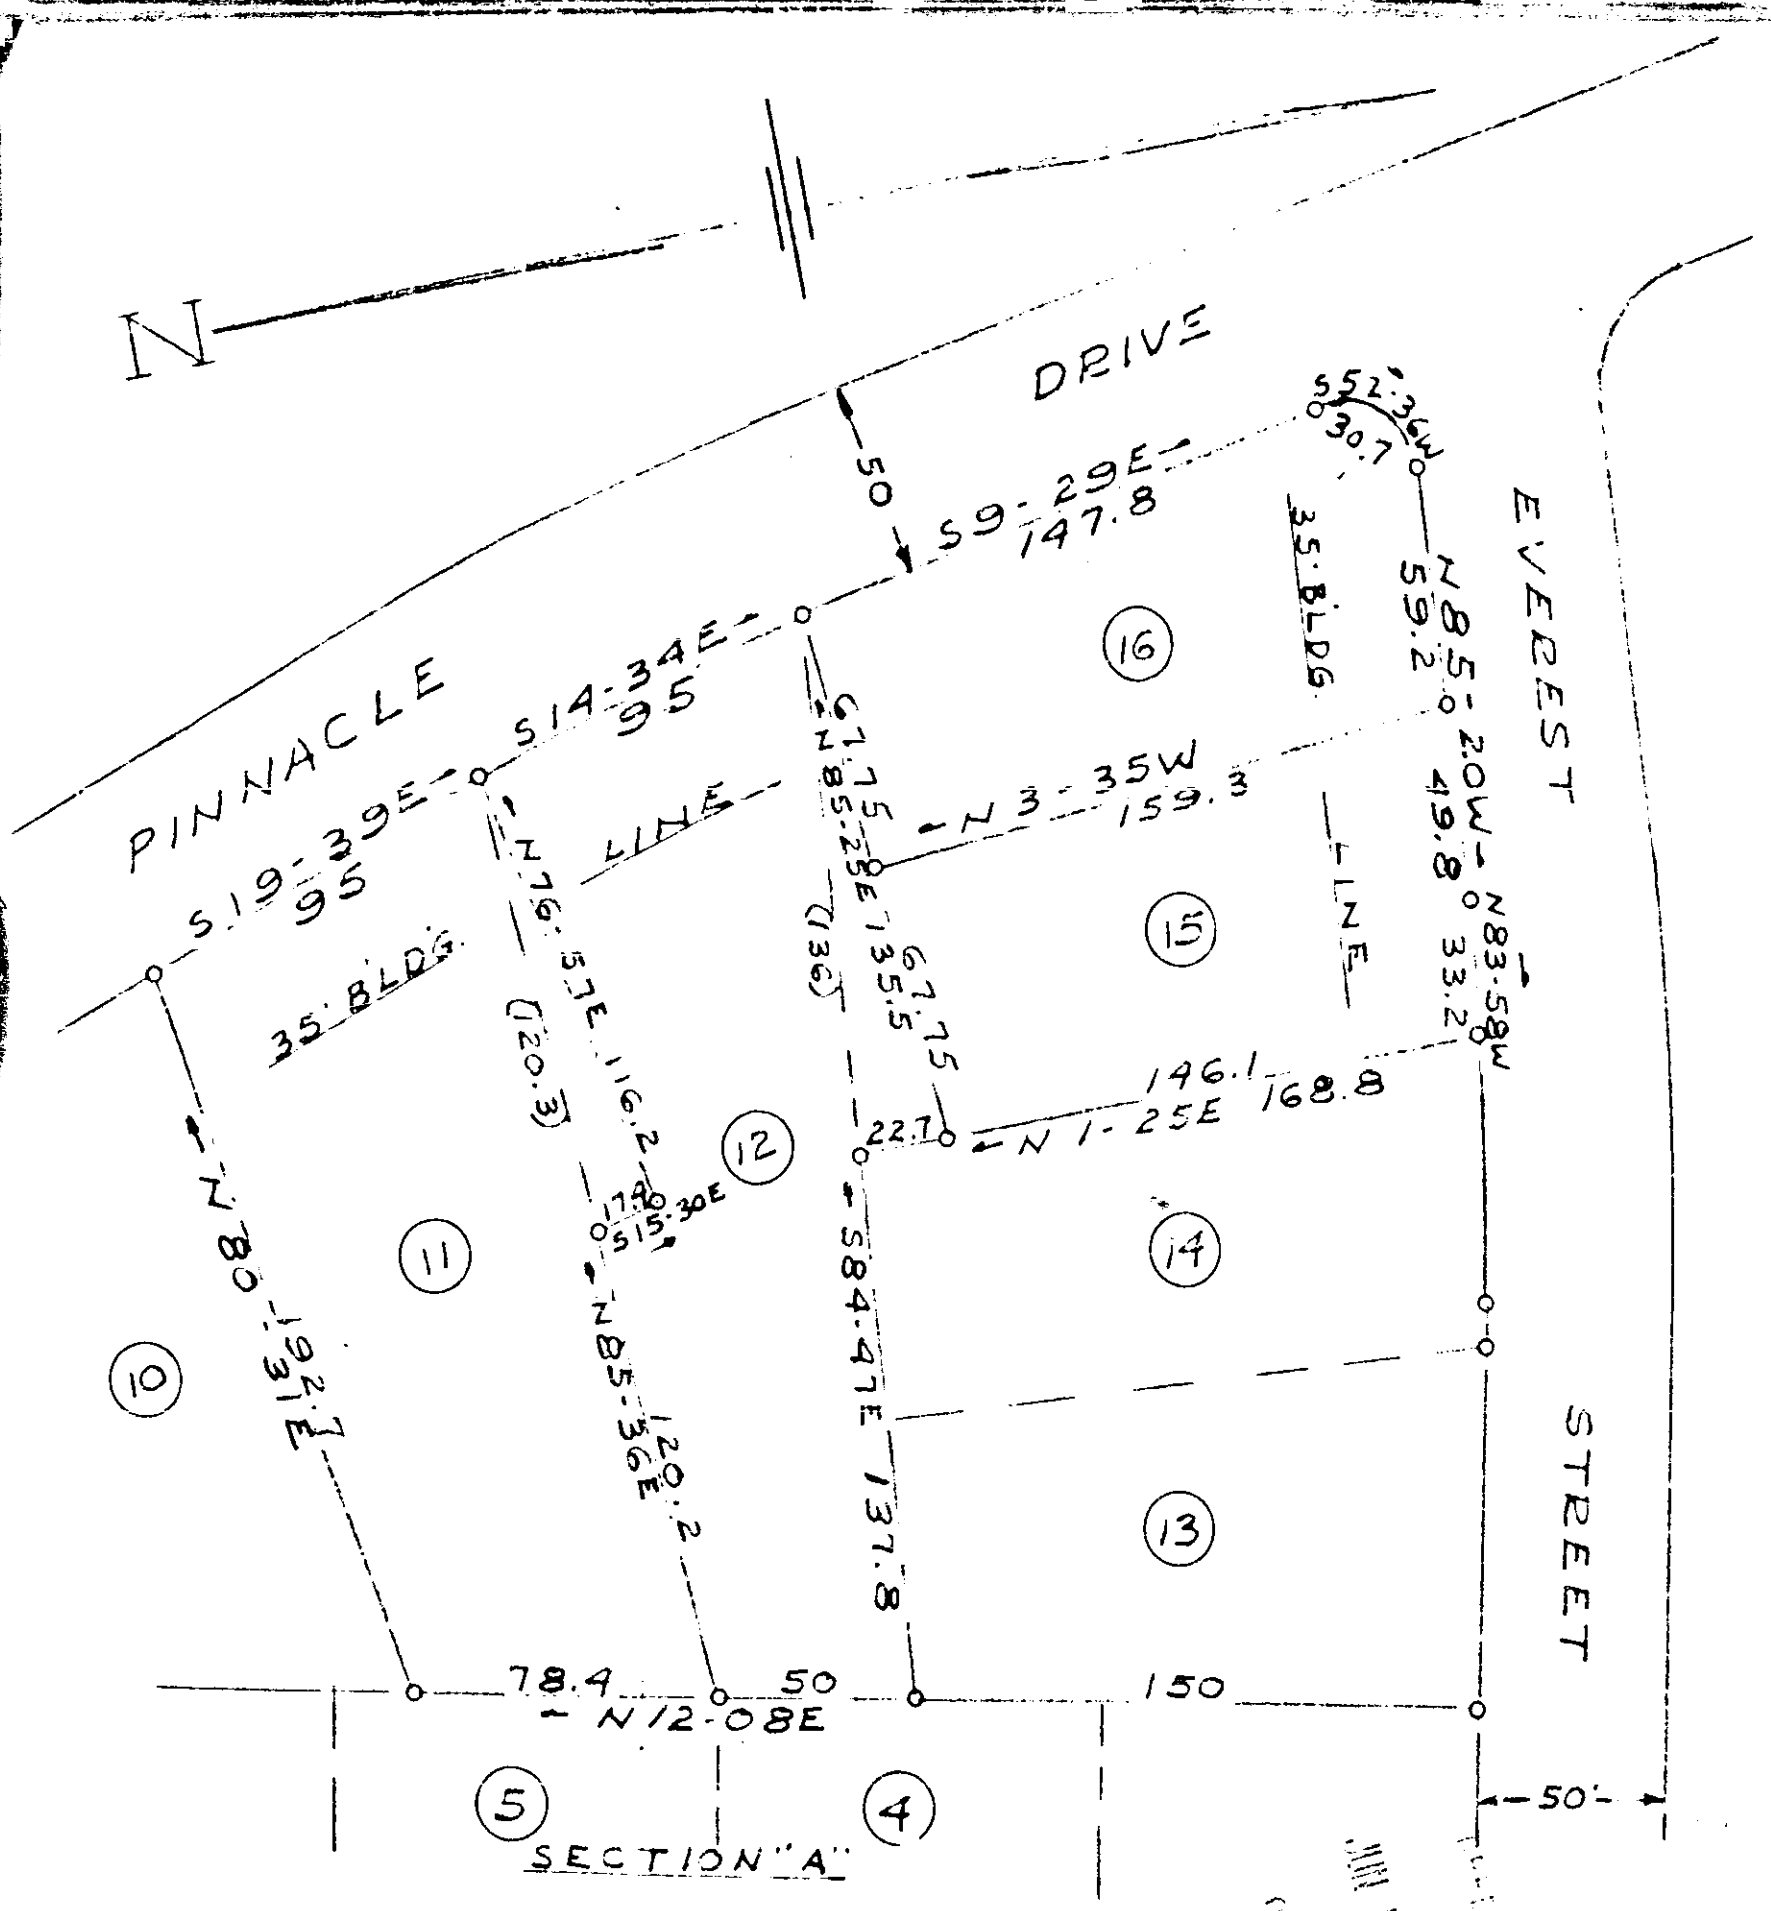

REVISION - LOTS 11-12-15-16
SECTION "B" GREEN FOREST
NEAR GREENVILLE S. C.
SCALE: 1" = 60' 28 MAY 1960

BY - J. MacRichardson - R.L.S. No. 598

JUN 11 10 54 AM 1960

FILED
GREENVILLE CO. S.C.

JUN 11 1960
34181

NOTE: Plat Section "B" GREEN FOREST recorded in R.M.C. Office in Plat Book KK Page 85

504

UU-21

- - - - Indicates Original Lot Line
Surveyed at request of Allen E. Vaughn.

Iron Pins all corners

34181 Filed This 11 day of June 1960
And Recorded in Vol. UU Page 21 at ____ M

Register Mesne Conveyance Greenville County, S. C.