


167

See plat T-106

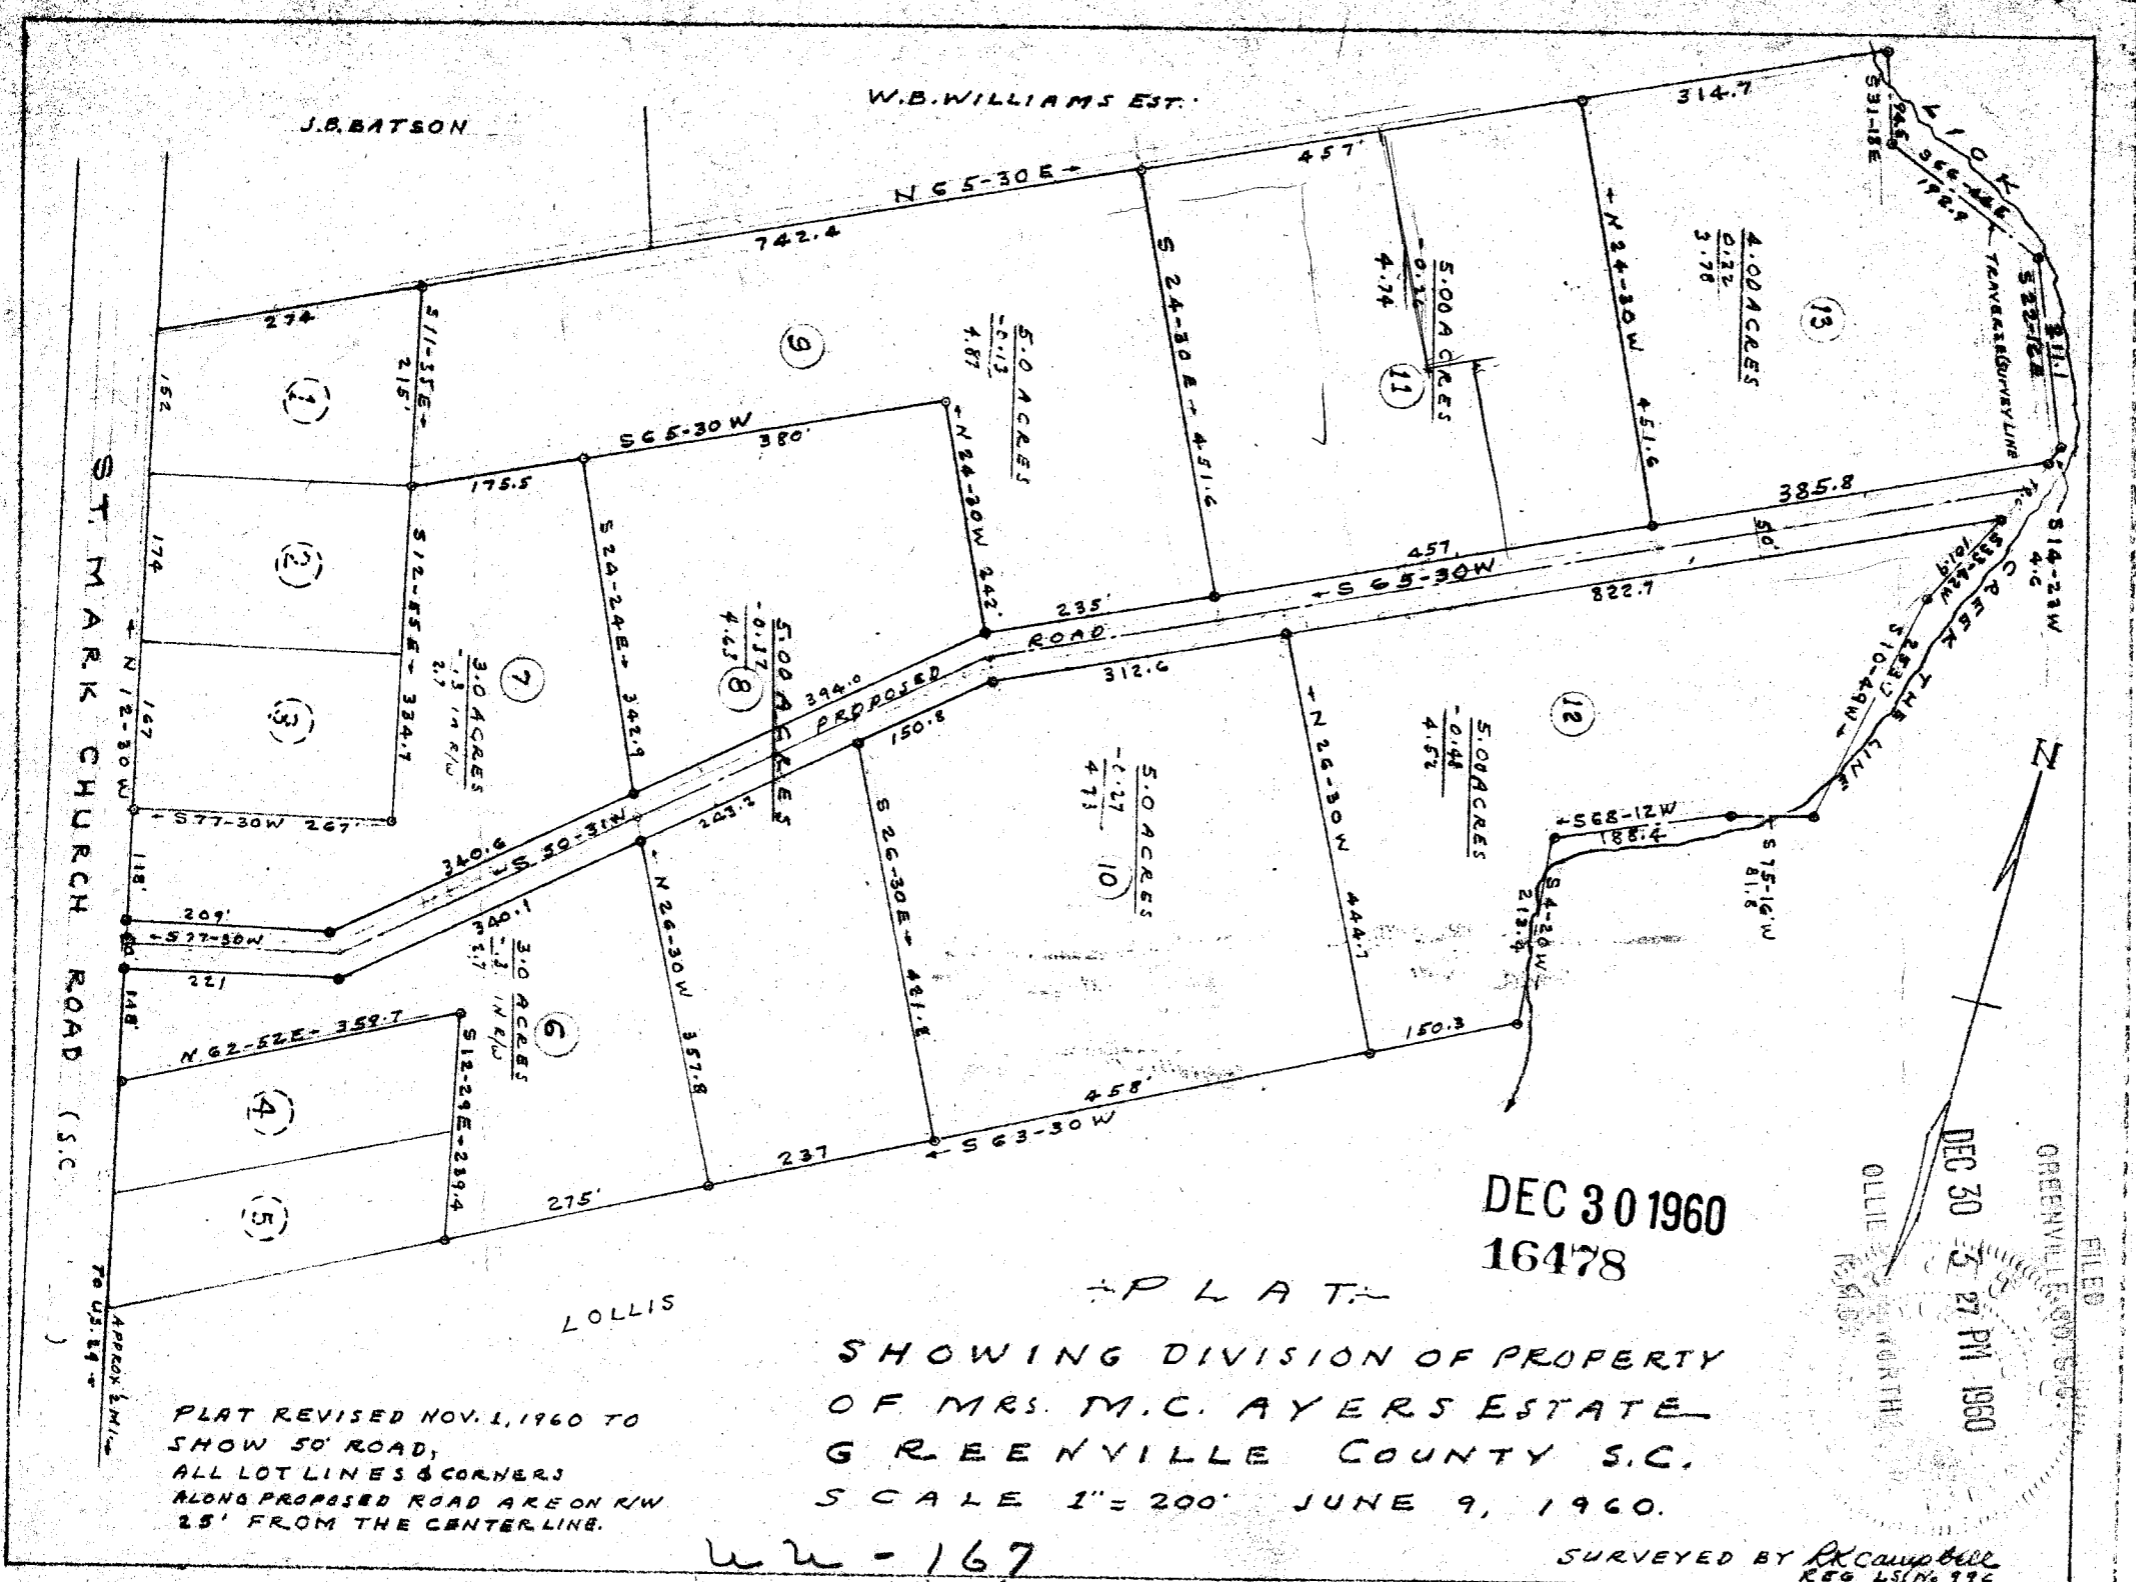

16478 Filed This 30 Day of Dec. 19 60
and Recorded in Vol. 1 Page 167 Plat

[Signature]
Register Mesne Conveyance Greenville County, S.C.