


Plat Book VV, Page 37A

REF: PLAT OF STONE LAKE HEIGHTS SECTION II
FILED IN PLAT BOOK 'W', PAGE 87

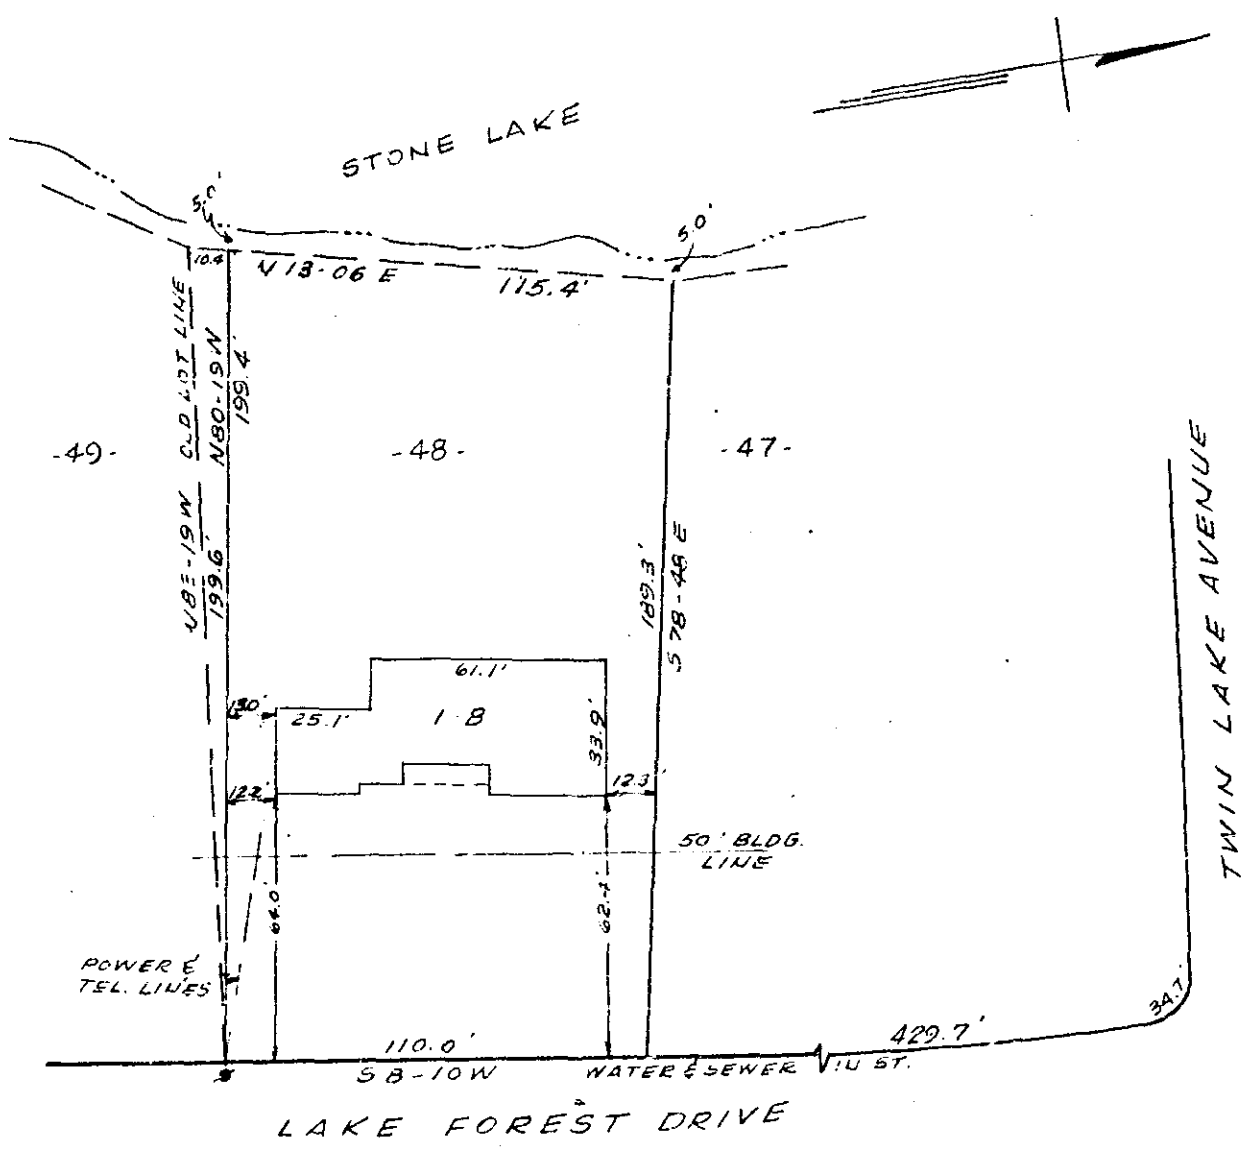

PROPERTY OF
ALLISTER G. SMITH
GREENVILLE, S.C.
SCALE 1"=50' FEB. 28, 1961

RECORDED
FEB 28 1961
GREENVILLE, S.C.

This is to certify that on the 28th day of February 1961 I surveyed the property shown on this plat, and that the property lines, walls and buildings are as shown hereon; that the buildings located on said lot do not encroach or project on adjacent streets or property, and that no adjacent walls or buildings encroach or project on this lot; and that there are no utility lines crossing this property except as shown.

21619

Raymond S. ...
Registered Engineer No. 962

MAR 2 1961

PIEDMONT ENGINEERING SERVICE
GREENVILLE, S. C.



50 @
VV-37

21619... Filed This 2 day of March 1961
and Recorded in Vol. VV Page 37 at ...
Adrian ...
Register Maine Conveyance Greenville County, S. C.