


Plat Book VV, Page 92

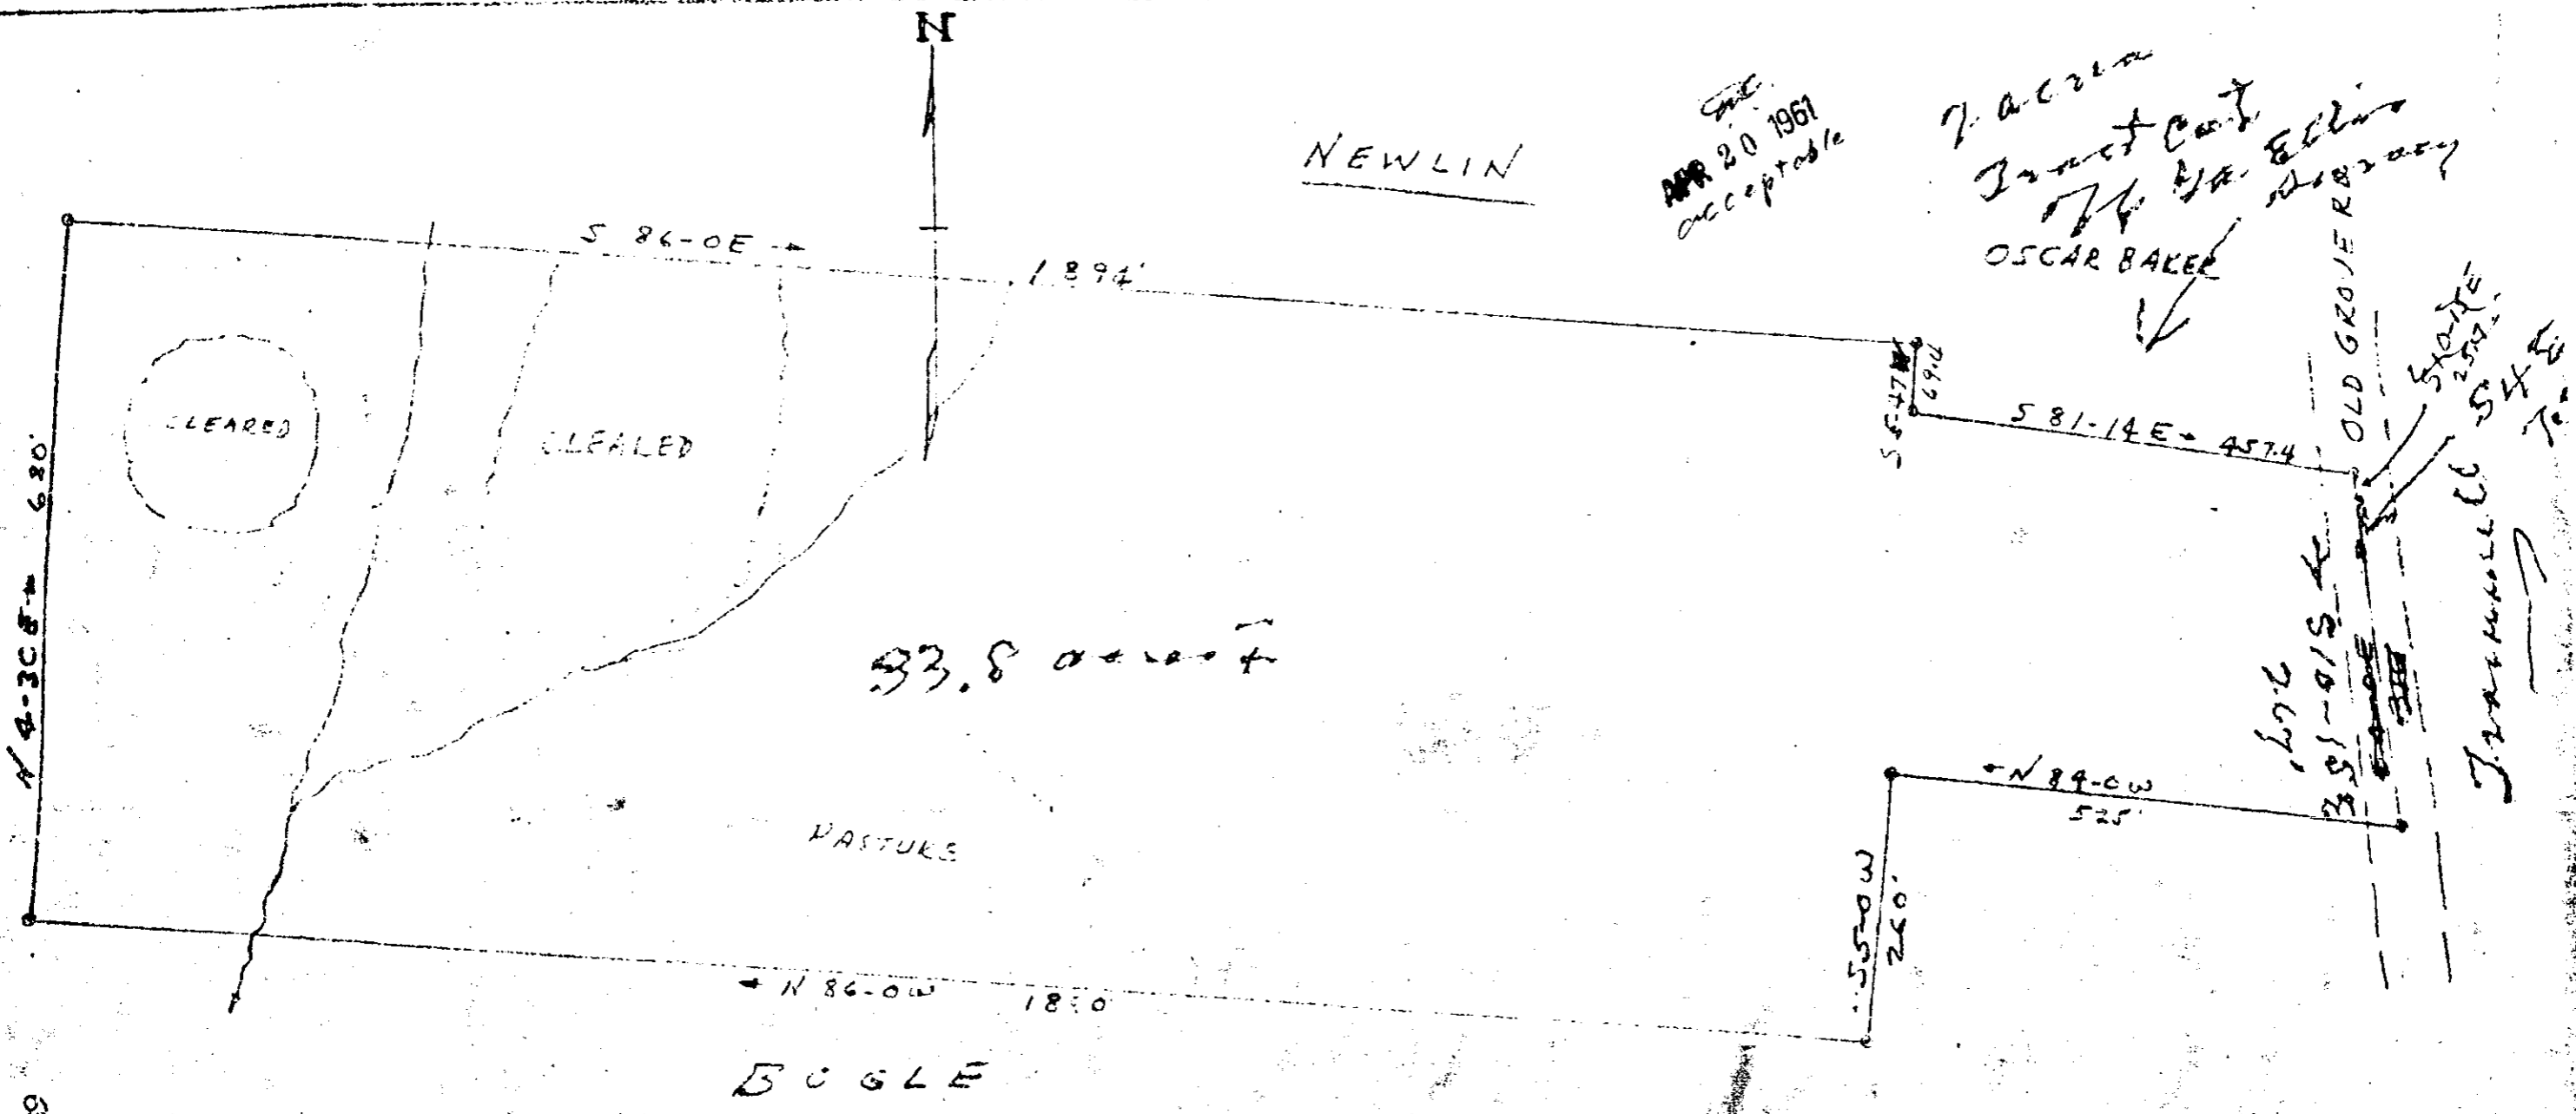

Application 206739
James E. Reid

PROPERTY OF
JAMES E. REID
GANTT TOWNSHIP
GREENVILLE COUNTY S.C.
SCALE 1" = 200' MAR. 1961

RECORDED
MAY 5 2 47 PM 1961

PLOTTED FROM LEE BY R.K. Campbell RLS N. 790

MAY 5 1961

100 parts in VV-92

27317 Filed This 5th day of May 1961
and Recorded in Vol. VV Page 92 at
Register Meane Conveyance Greenville County, S. C.