


Plat Book VV, Page 157 A

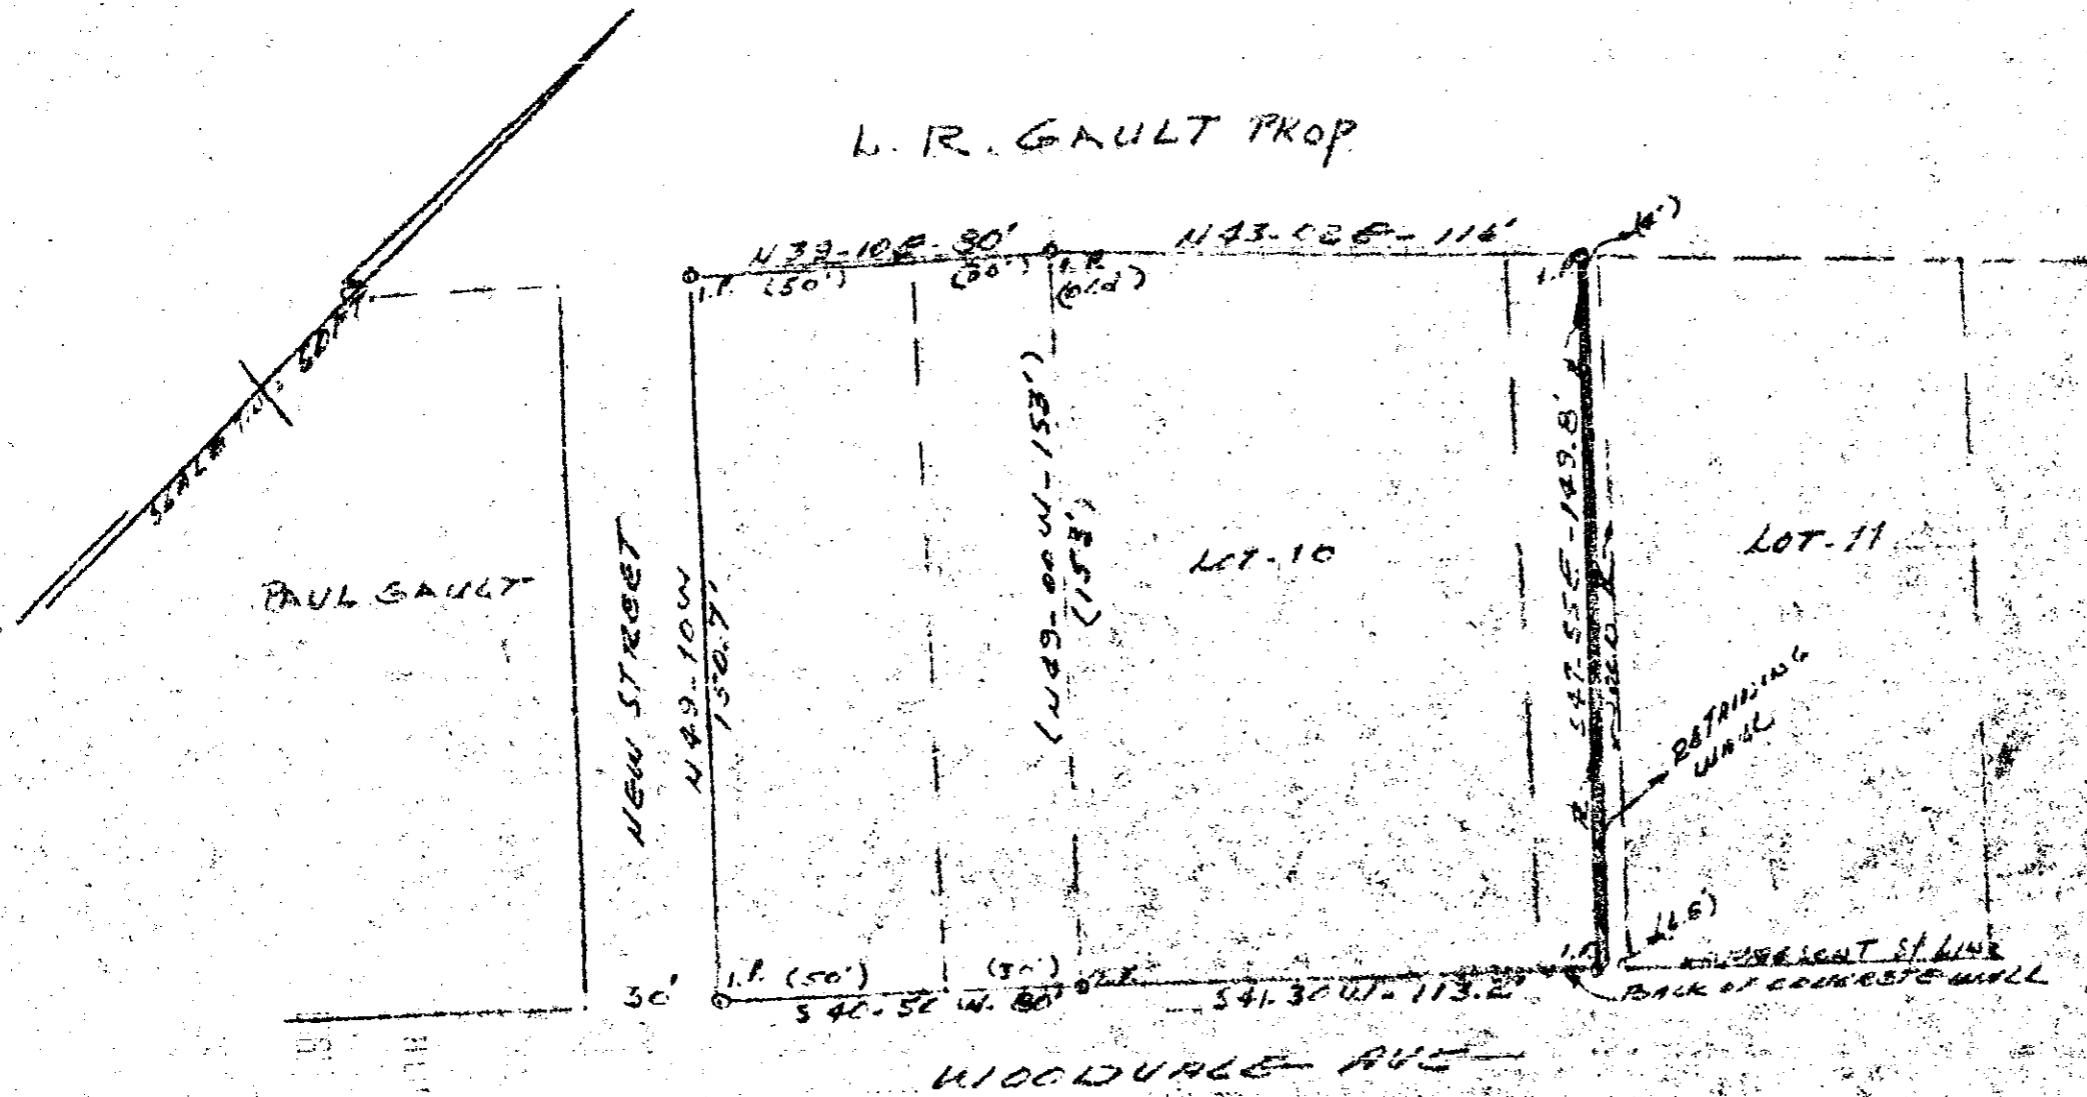

PAUL GAULT

NEW STREET

L. R. GAULT PROP

LOT-10

LOT-11


PROPERTY OF
H. B. MOORHEAD
CITY OF FOUNTAIN INN S.C.
GREENVILLE COUNTY

1160
JUL 8 1961

SURVEYED BY
LEWIS C. GOOSEY, R.L.S.
MAY 27, 1961 - LAURENS, S.C.

50d posts in

VV-157

1160 filed this 8 day of July 1961
and recorded in Vol. VV Page 157 of Plats
