Plat Book-XX-Page 85C

85

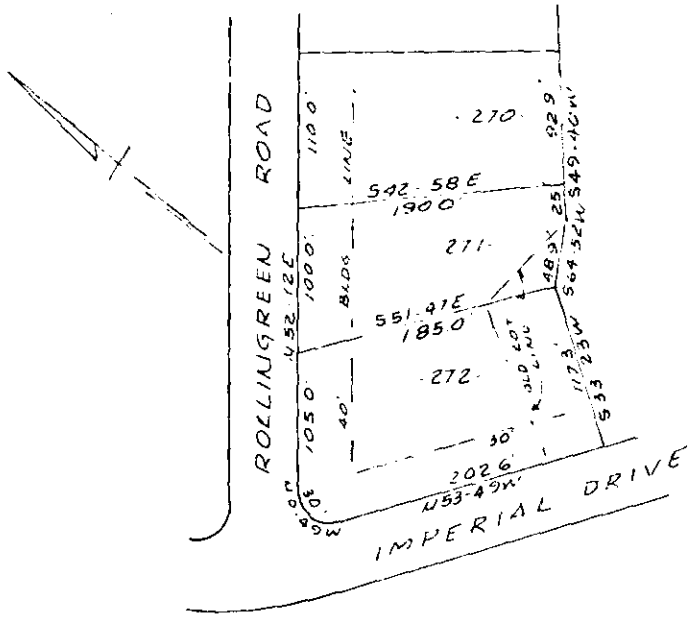

REVISION OF LOTS 271 & 272
BOTANY WOODS SECT V
GREENVILLE, S C
SCALE 1" = 100' 9 NOV. 1961

Filed This 11 day of Oct 1962 at 8:55 A.M.
and Recorded in Vol. XX Page 85
Register Mesne Conveyance Greenville County, S. C.

OCT 11 1962

FILED
GREENVILLE CO. S.C.
OCT 11 10 30 AM 1962
ELLIS FARNSWORTH
R.M.C.

PIEDMONT ENGINEERING SERVICE
GREENVILLE S C

XX-85